


JOB NO.: E526

STREET ADDRESS: HSE#15 LULL STREET

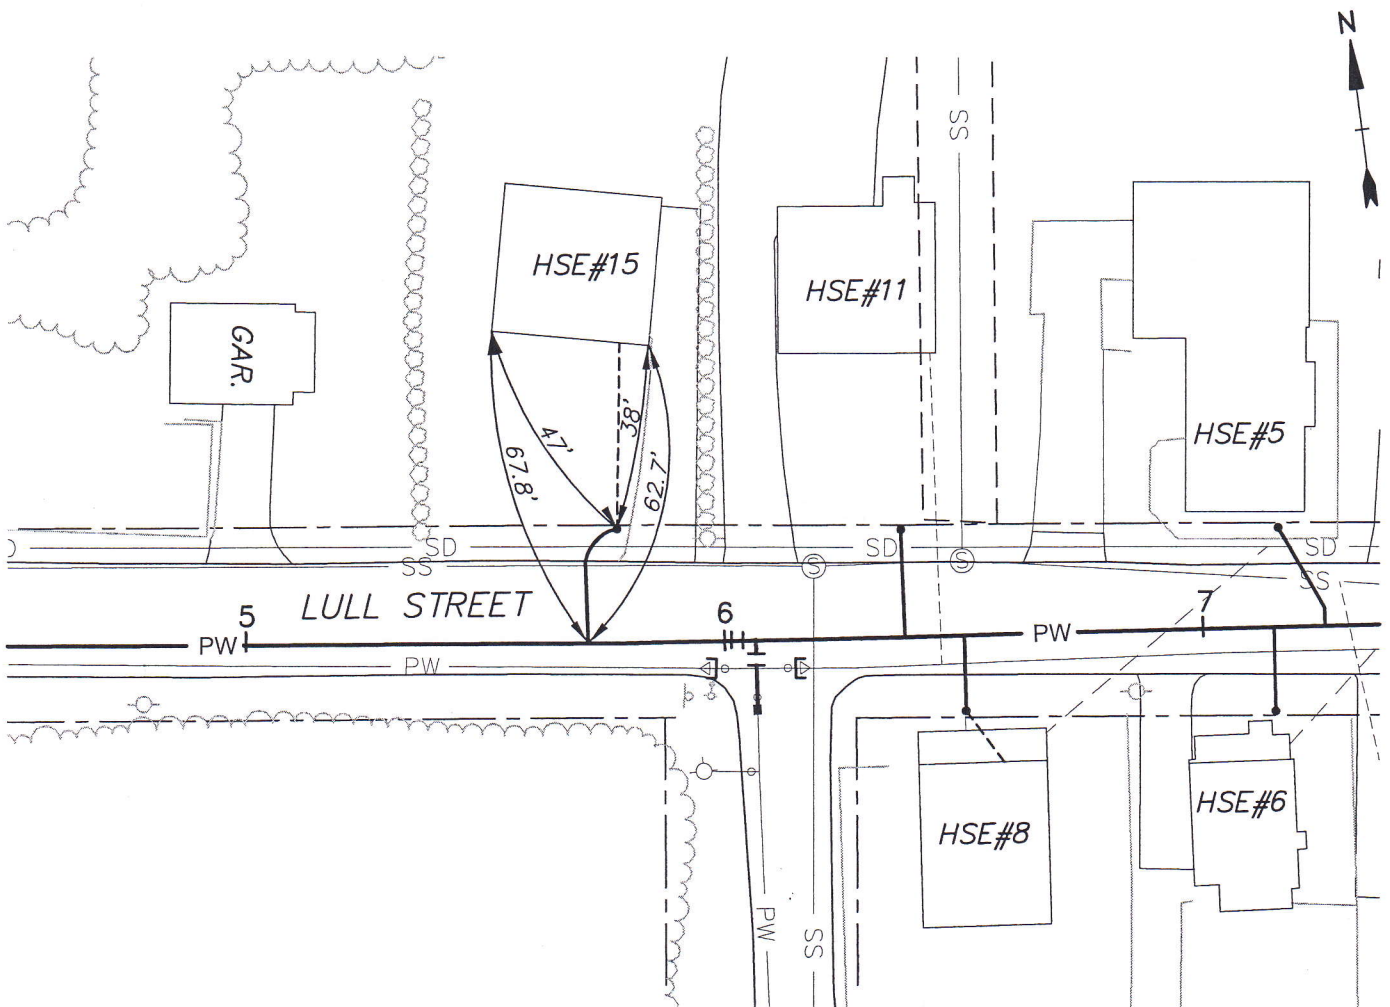

LOAM & SEED	<u>10.0'x6.5'</u>
BIT. DRIVEWAY	<u> </u>
BIT. CURBS	<u>4.7'</u>
BIT. SIDEWALK	<u> </u>
CONC. CURB	<u> </u>
CONC. SIDEWALK	<u> </u>
TRENCH	<u>18.0'x6.5'</u>

SERVICE INSTALLED: 8-21-07

SIZE: 1"

MATERIAL: 1-CORP., 1-C. STOP WITH BOX

DEPTH AT MAIN: 5.0'

DEPTH AT CURB STOP: 5.5'

LENGTH OF Cu PIPE: 25.0'+1.0'=26'

*COPPER UNDER DRAIN PIPE