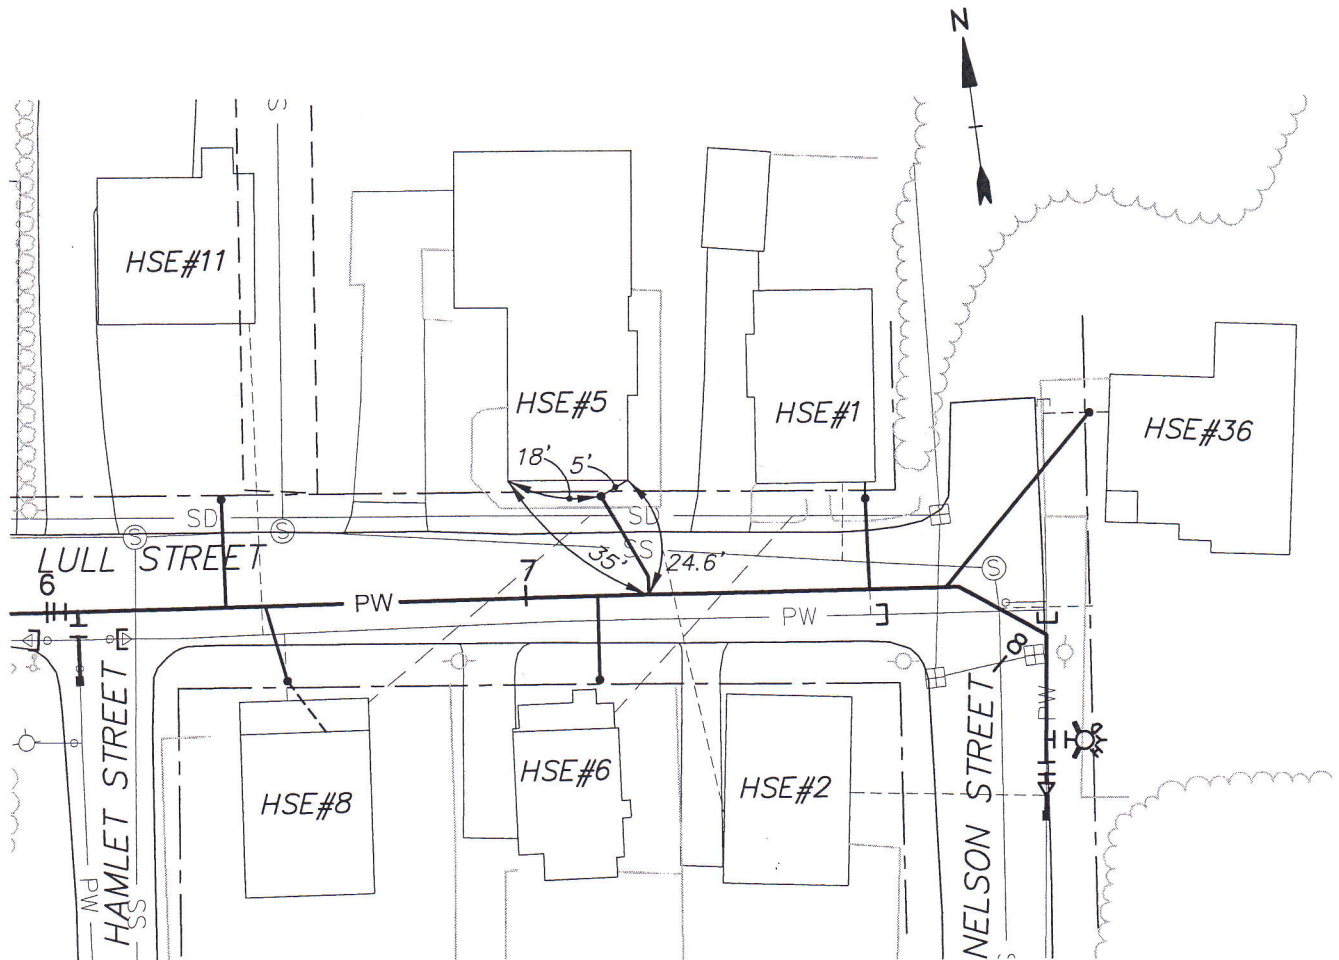


STREET ADDRESS: HSE#5 LULL STREET

LOAM & SEED	<u>4.0'x4.0'</u>
BIT. DRIVEWAY	<u> </u>
BIT. CURBS	<u>6.2'</u>
BIT. SIDEWALK	<u> </u>
CONC. CURB	<u> </u>
CONC. SIDEWALK	<u> </u>
TRENCH	<u>20.0'x4.0'</u>

SERVICE INSTALLED:	<u>8-22-07</u>
SIZE:	<u>1"</u>
MATERIAL:	<u>1-CORP., 1-C. STOP WITH BOX</u>
DEPTH AT MAIN:	<u>5.0'</u>
DEPTH AT CURB STOP:*	<u>4.5'</u>
LENGTH OF Cu PIPE:	<u>19.5'+1.0'=20.5'</u>

*C. STOP ON DRAIN PIPE