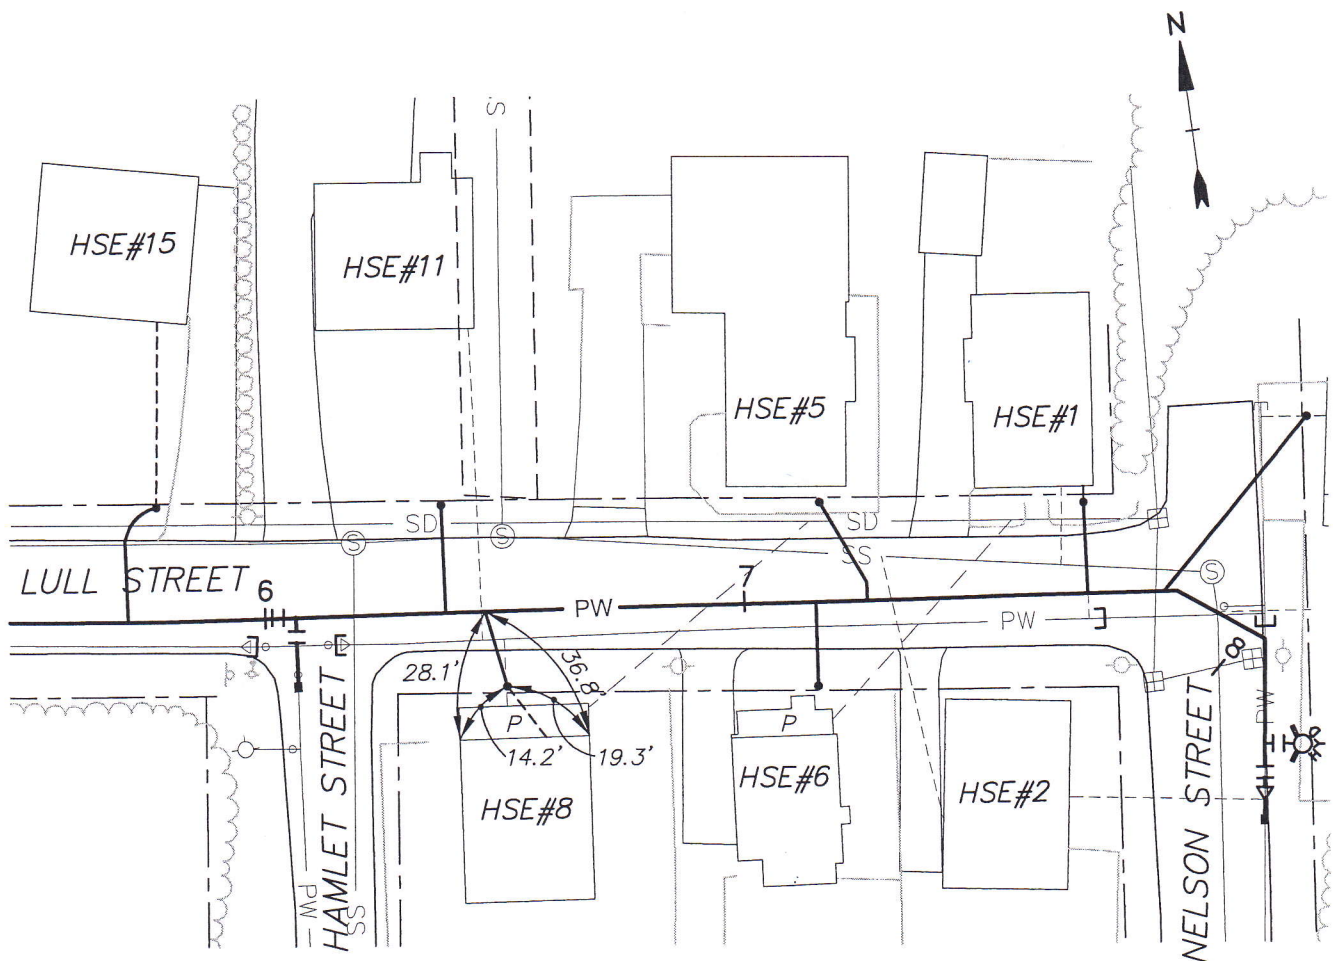


STREET ADDRESS: HSE#8 LULL STREET

LOAM & SEED	5.5'x10.0'
BIT. DRIVEWAY	
BIT. CURBS	5.5'
BIT. SIDEWALK	
CONC. CURB	
CONC. SIDEWALK	
TRENCH	11.3'x5.1'

SERVICE INSTALLED:	8-20-07
SIZE:	1"
MATERIAL:	1-CORP., 1-C. STOP WITH BOX
DEPTH AT MAIN:	4.7'
DEPTH AT CURB STOP:	5.0'
LENGTH OF Cu PIPE:	21.0'+2.0'=23'

\*T+M ON 8-21-07  
R&R IRON PIPE INTO HOUSE AND  
REPLACED WITH 3/4" Cu (20'  
LENGTH CUT)