



EAST LONGMEADOW DEPARTMENT OF PUBLIC WORKS

Job: 55 MAPLE ST. of _____
Sheet No: _____ Date: _____
Calculated By: _____
Scale: _____

Common meter


Act. # 013422 - meter # 48438315
mod # 86975144

#59 Jack Chen

Act # 013424 meter # 48438834
mod # 86975528

Cruise Store (Sink)

Act # 013421 meter # 47838506
mod # 86628903

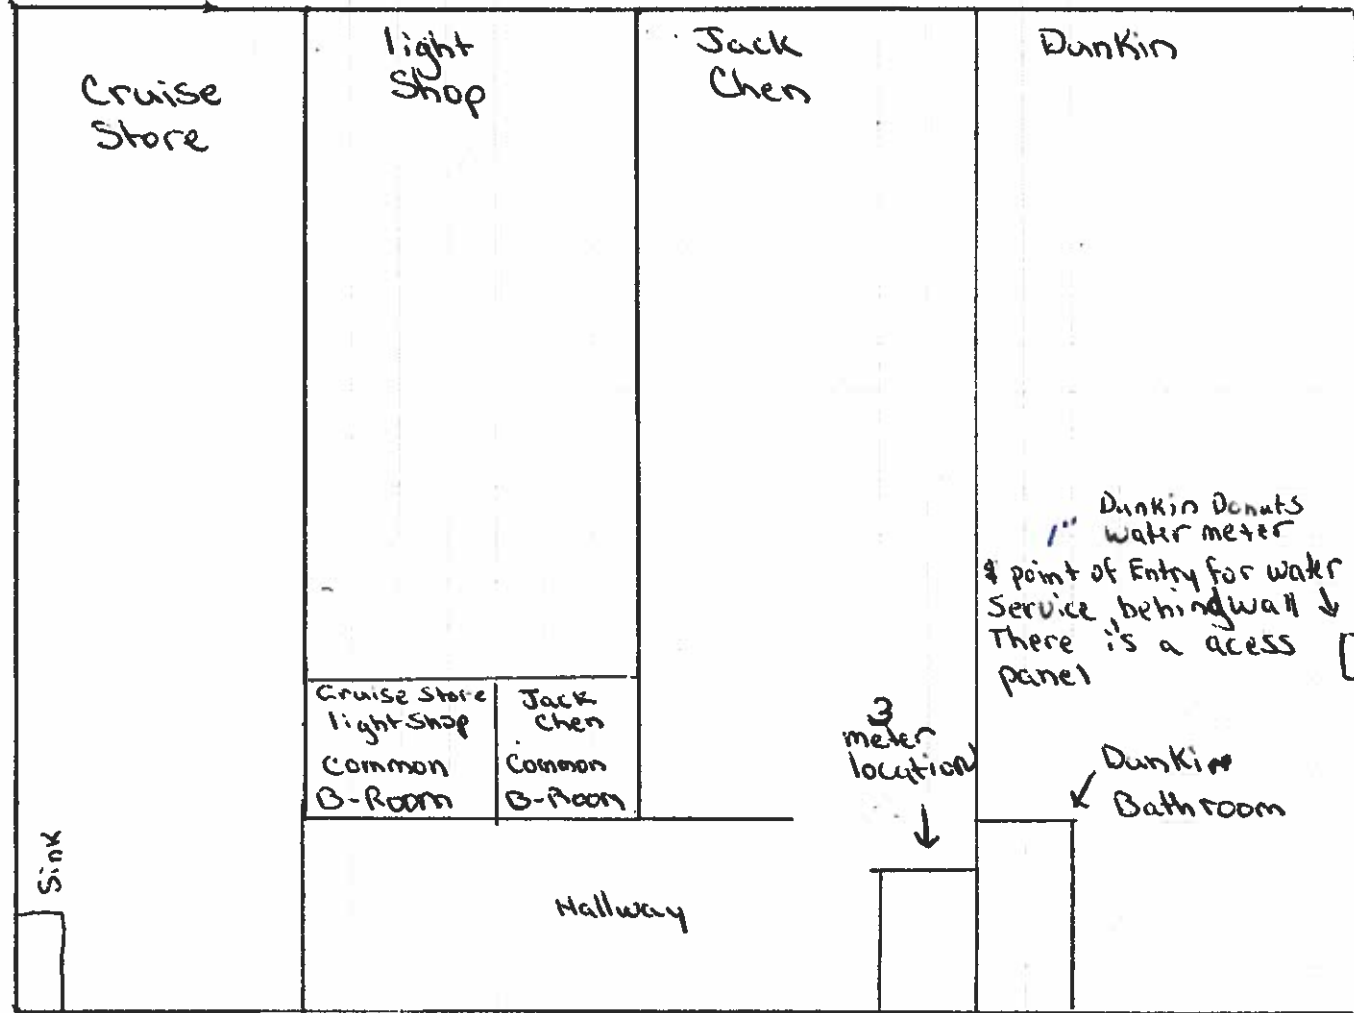

The 2 Common Bathrooms are on the common meter
Dunkin's Bathroom is on Dunkin's water meter