



EAST LONGMEADOW DEPARTMENT OF PUBLIC WORKS

Job: Water Curb Box

Sheet No: 198 Maple St. of _____

Calculated By: Chad. R + Don. T Date 4-2-2018

Scale: _____

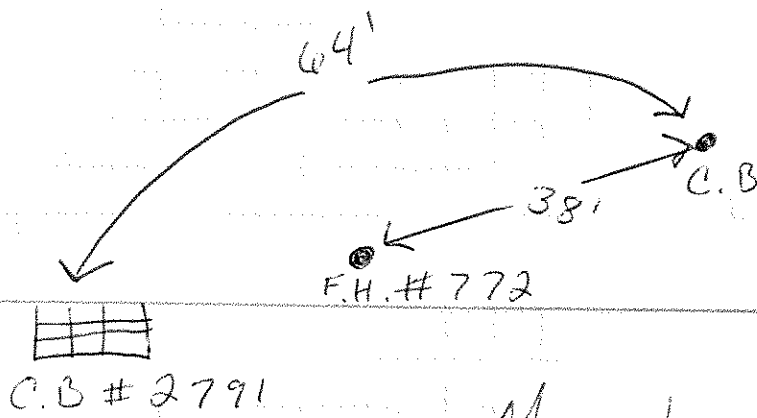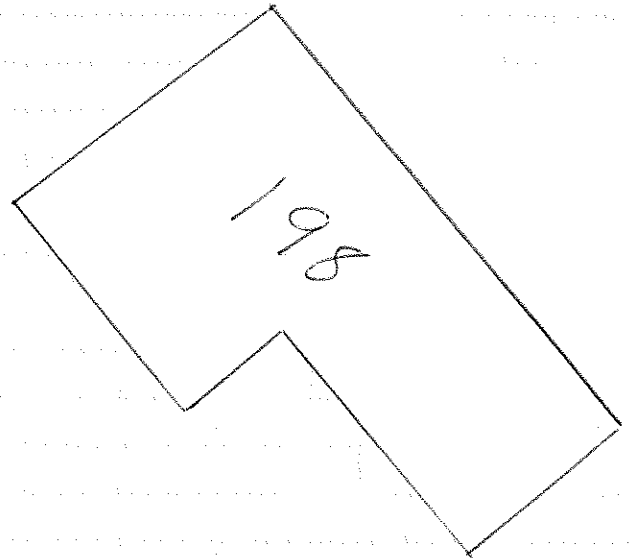

Maple St.