


47
STORE

39
Restaurant


6" to 4" tie in
MAPLE TO LEGION
by
CARACAS CONST.
6-1-2020
12" AC DIA 14.33

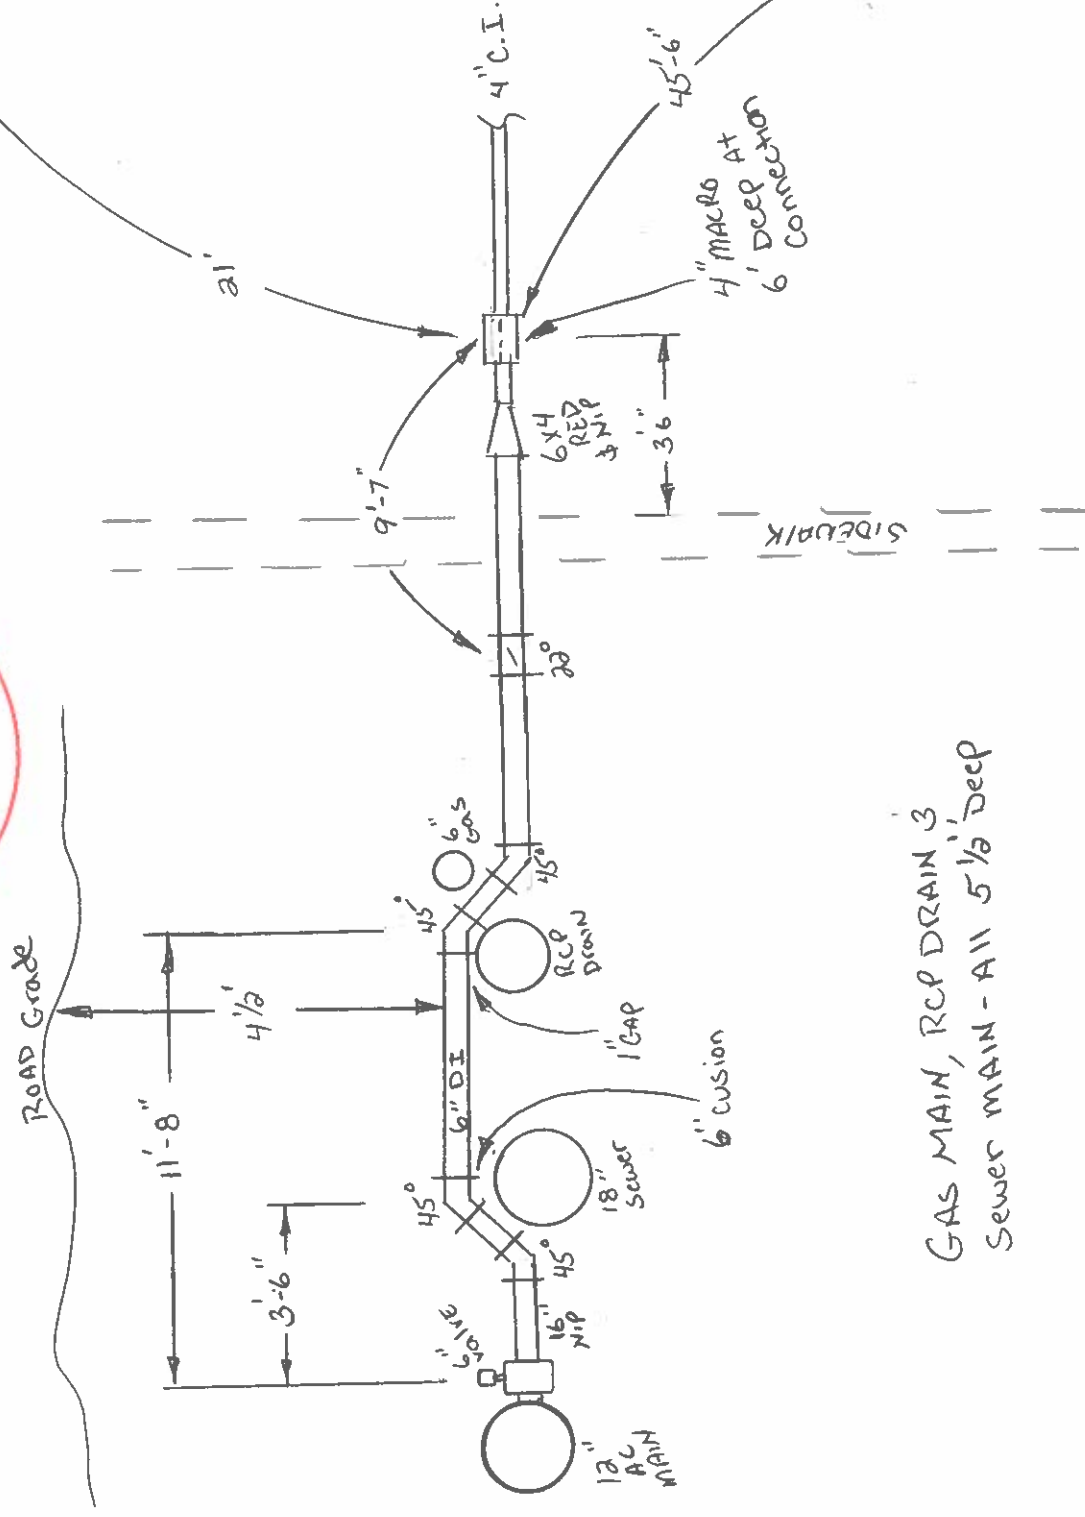

GAS MAIN, RCP DRAIN 3'
SEWER MAIN - ALL 5' 1/2" DEEP

MAPLE COURT
TIE-IN BY
CARACAS CONST.
6-4-2020

12" AC DIA 14.33

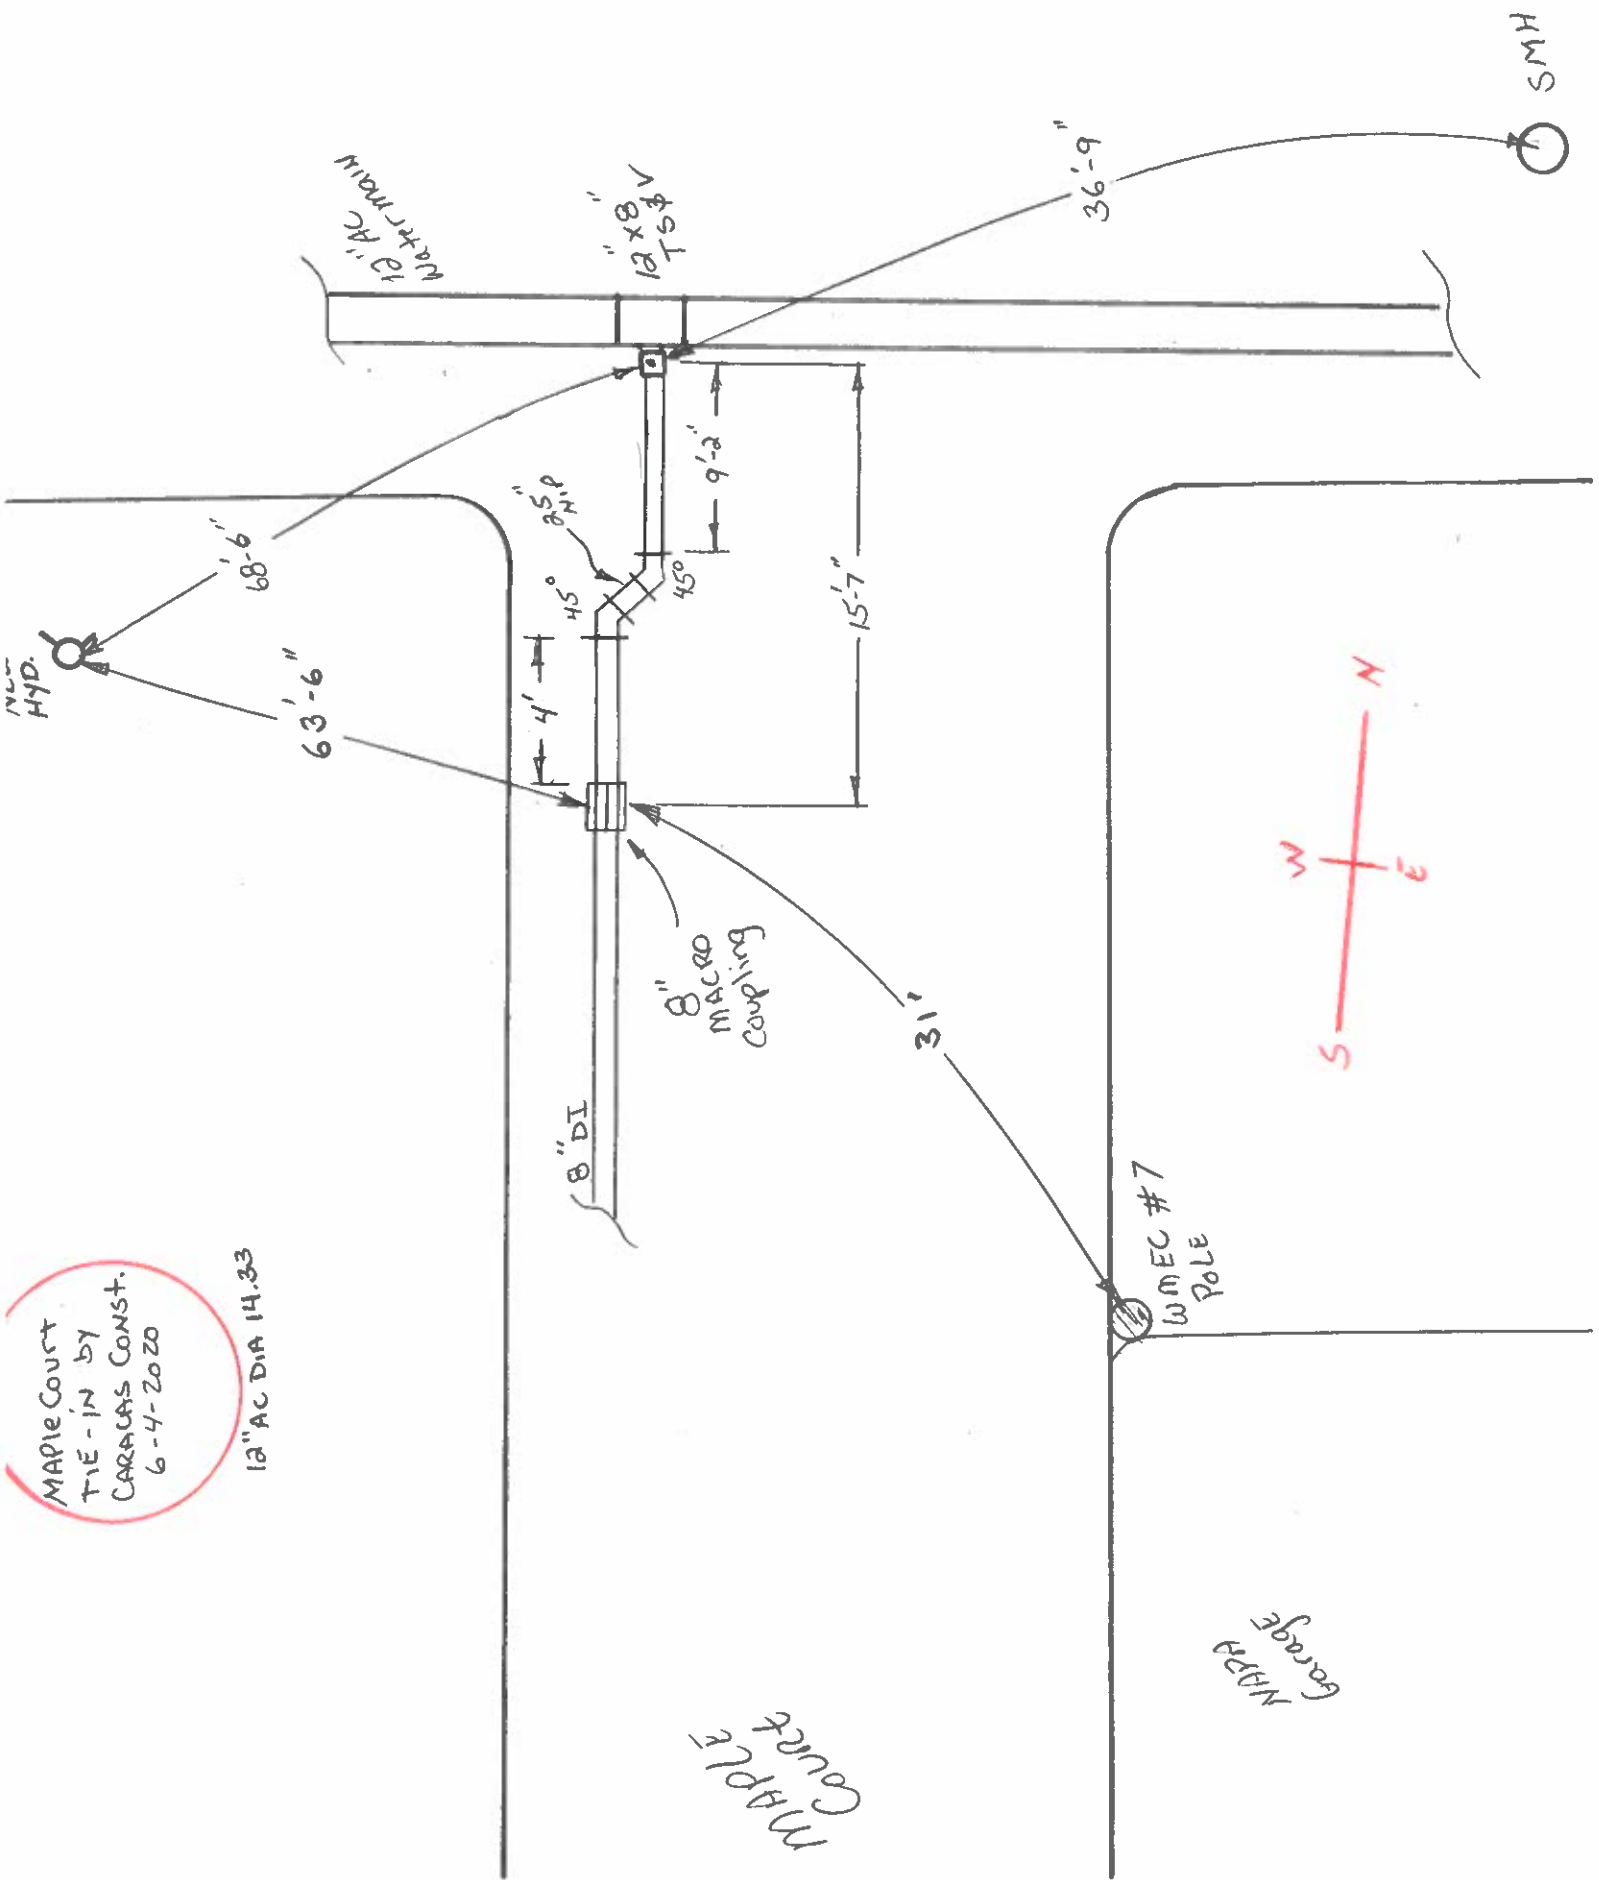

MAPLE
COURT

Garage

WMEC #7
POLE



SMH

CURB

12"x8" TS 3/4"

12" AC MAIN - 6' DEEP

8" Gate Valve

MAPLE

DRAIN MH

12" DRAIN RCP

6" GAS 4'-4" DEEP

Thrust Blocks

Basin

8" MACRO X NIP
X CAP


Thrust
Blocks

8" MACRO
Coupling

BALDWIN tie in
By
CARACAS CONST.
5-29-2020


12" AC DIA 14.33

BALDWIN

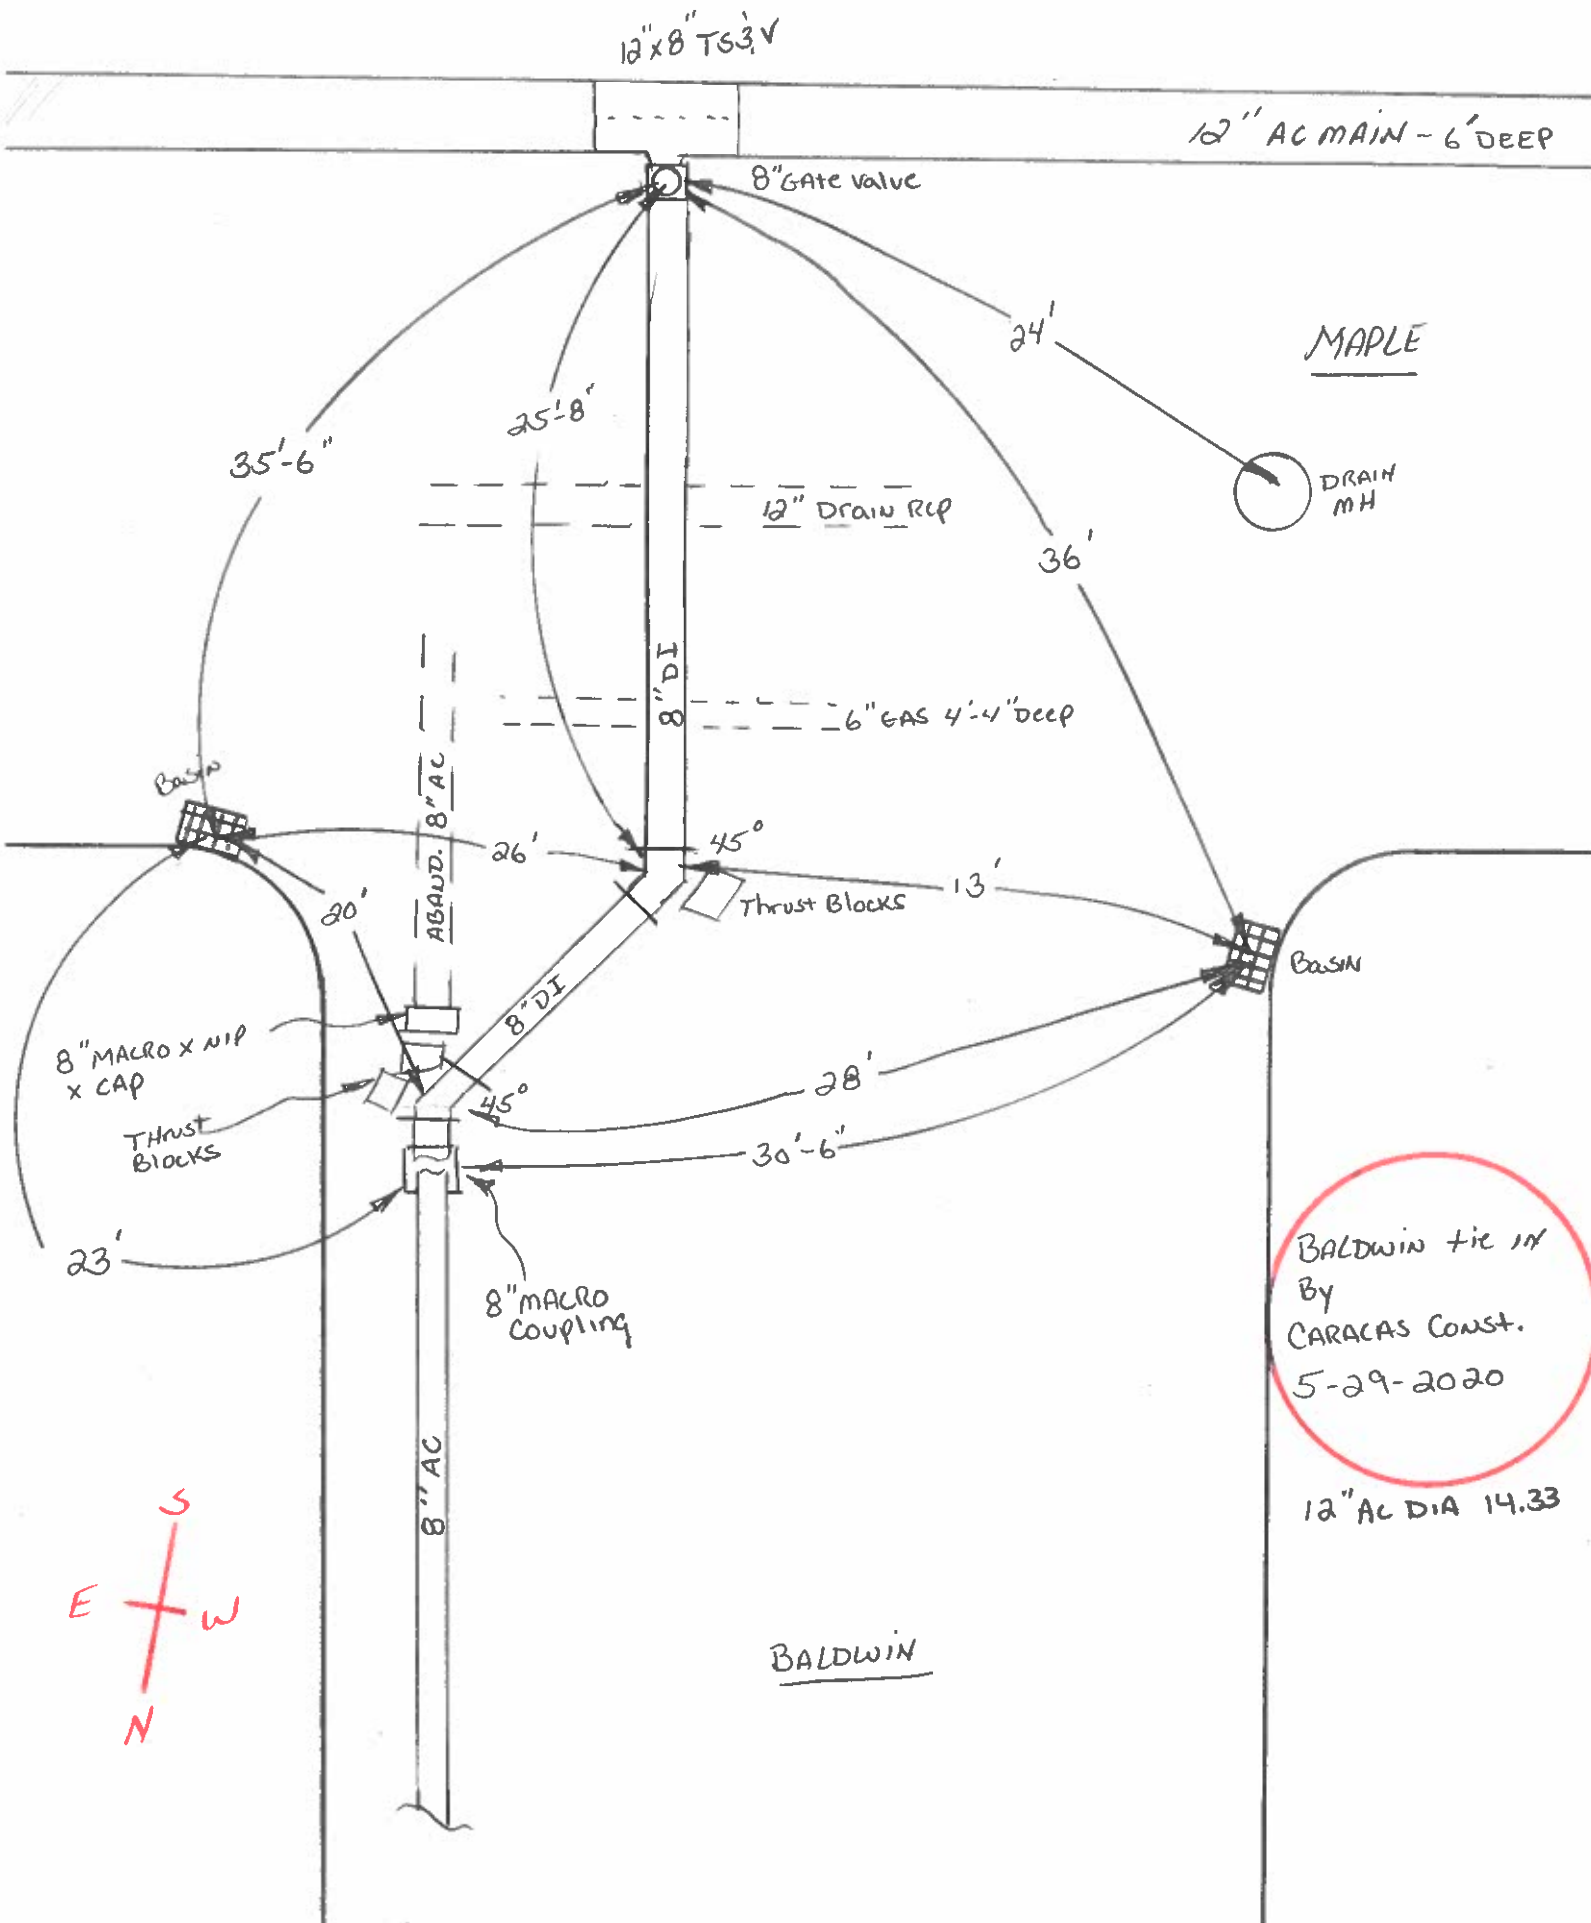


Baldwin Connection Across Maple Street

By CAROLAS CONST.
5-29-2020

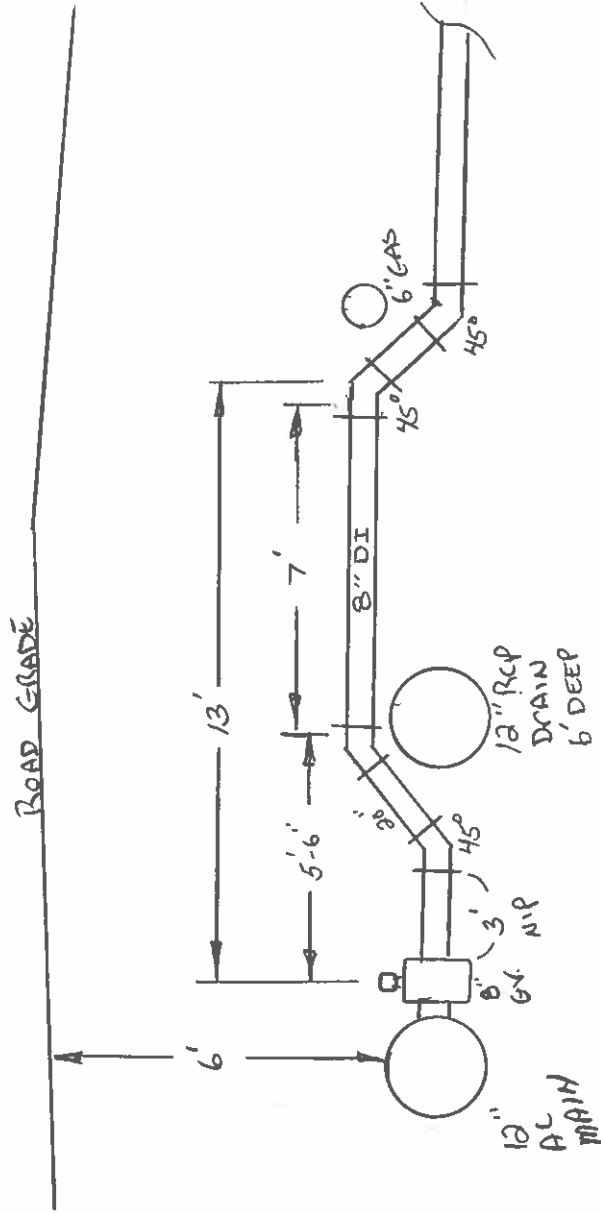

8" - 6" Fire
Service stubs
by
CARACAS Construction
6-29-2020

12" AC DIA 14.33

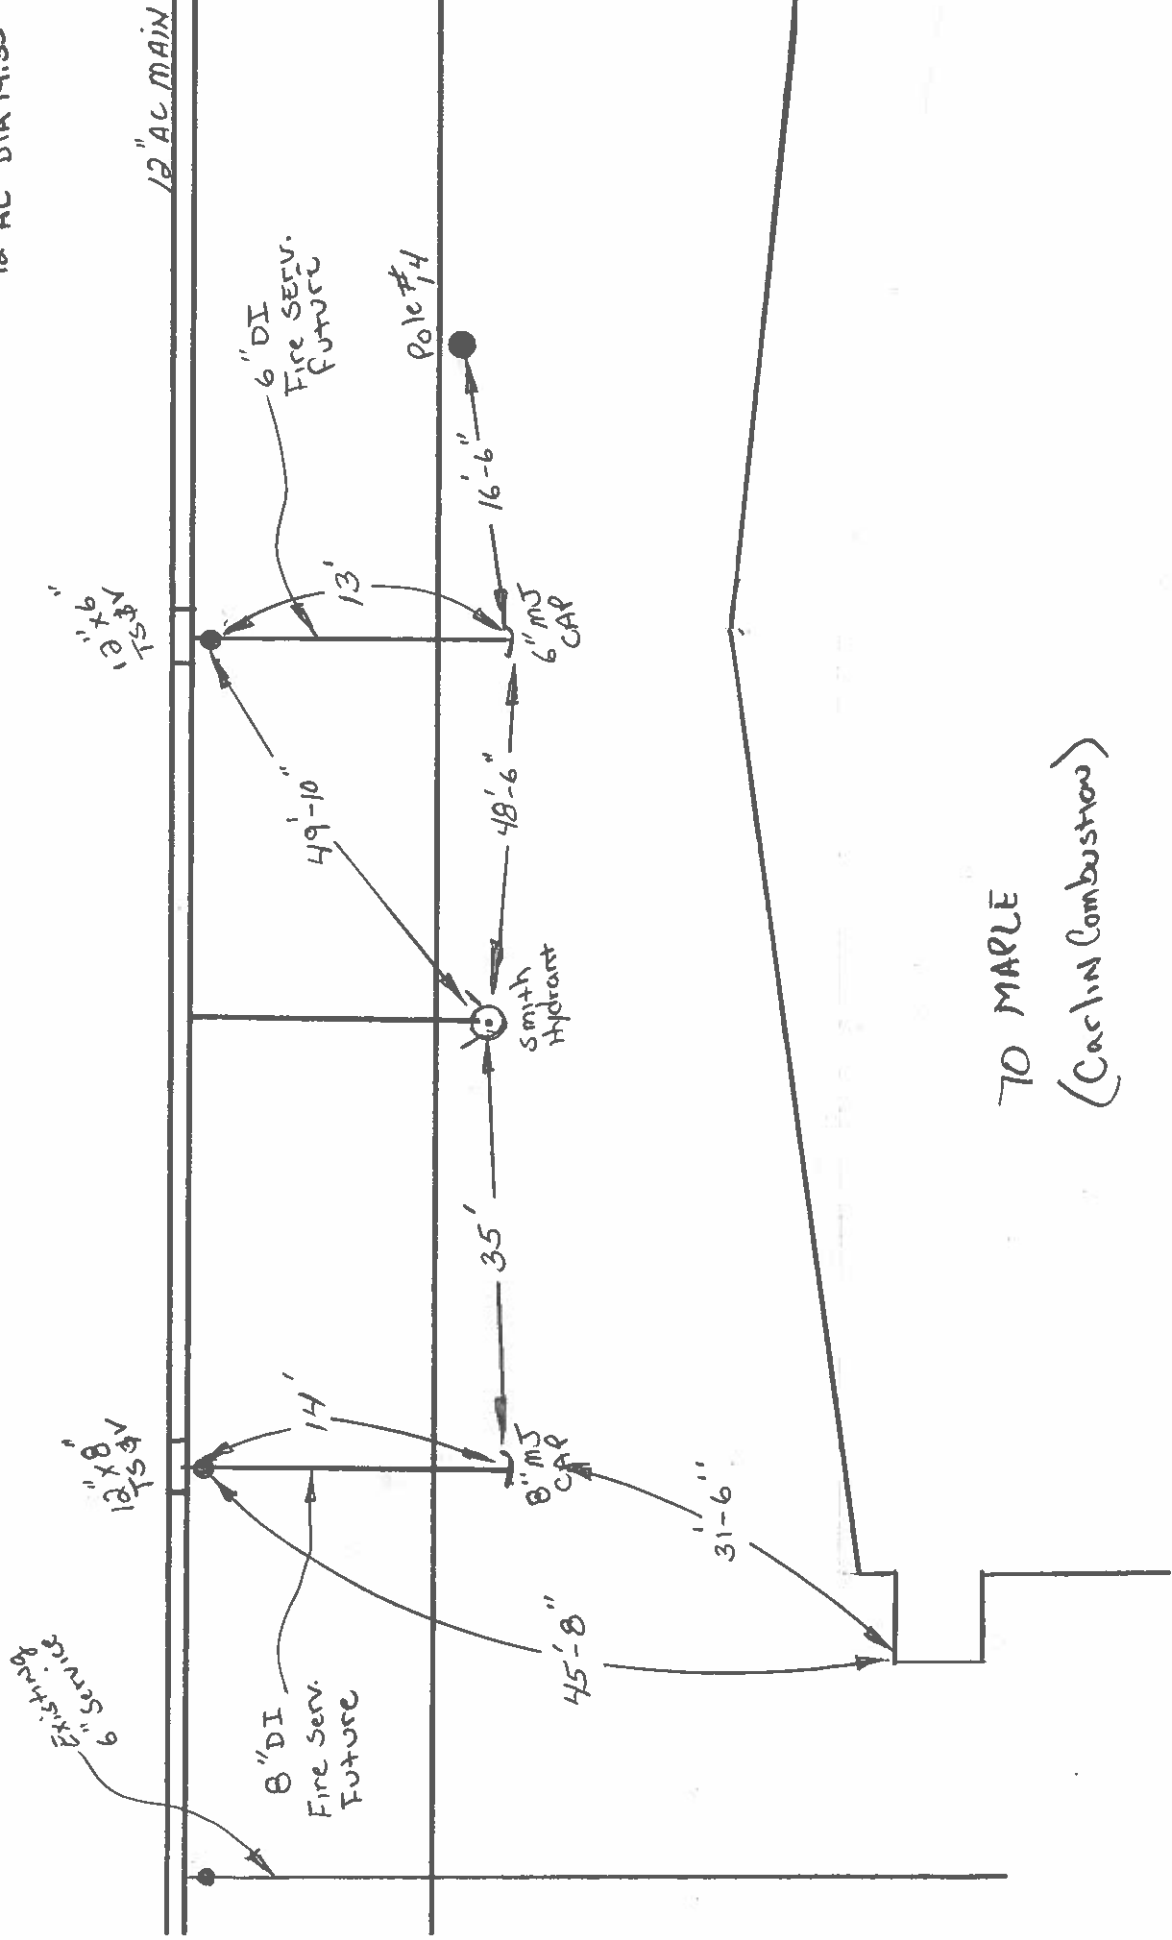


Pradny

EDMUND.
TIE-IN
By Caracus Coast.
6-9-2020

Edmund


66#

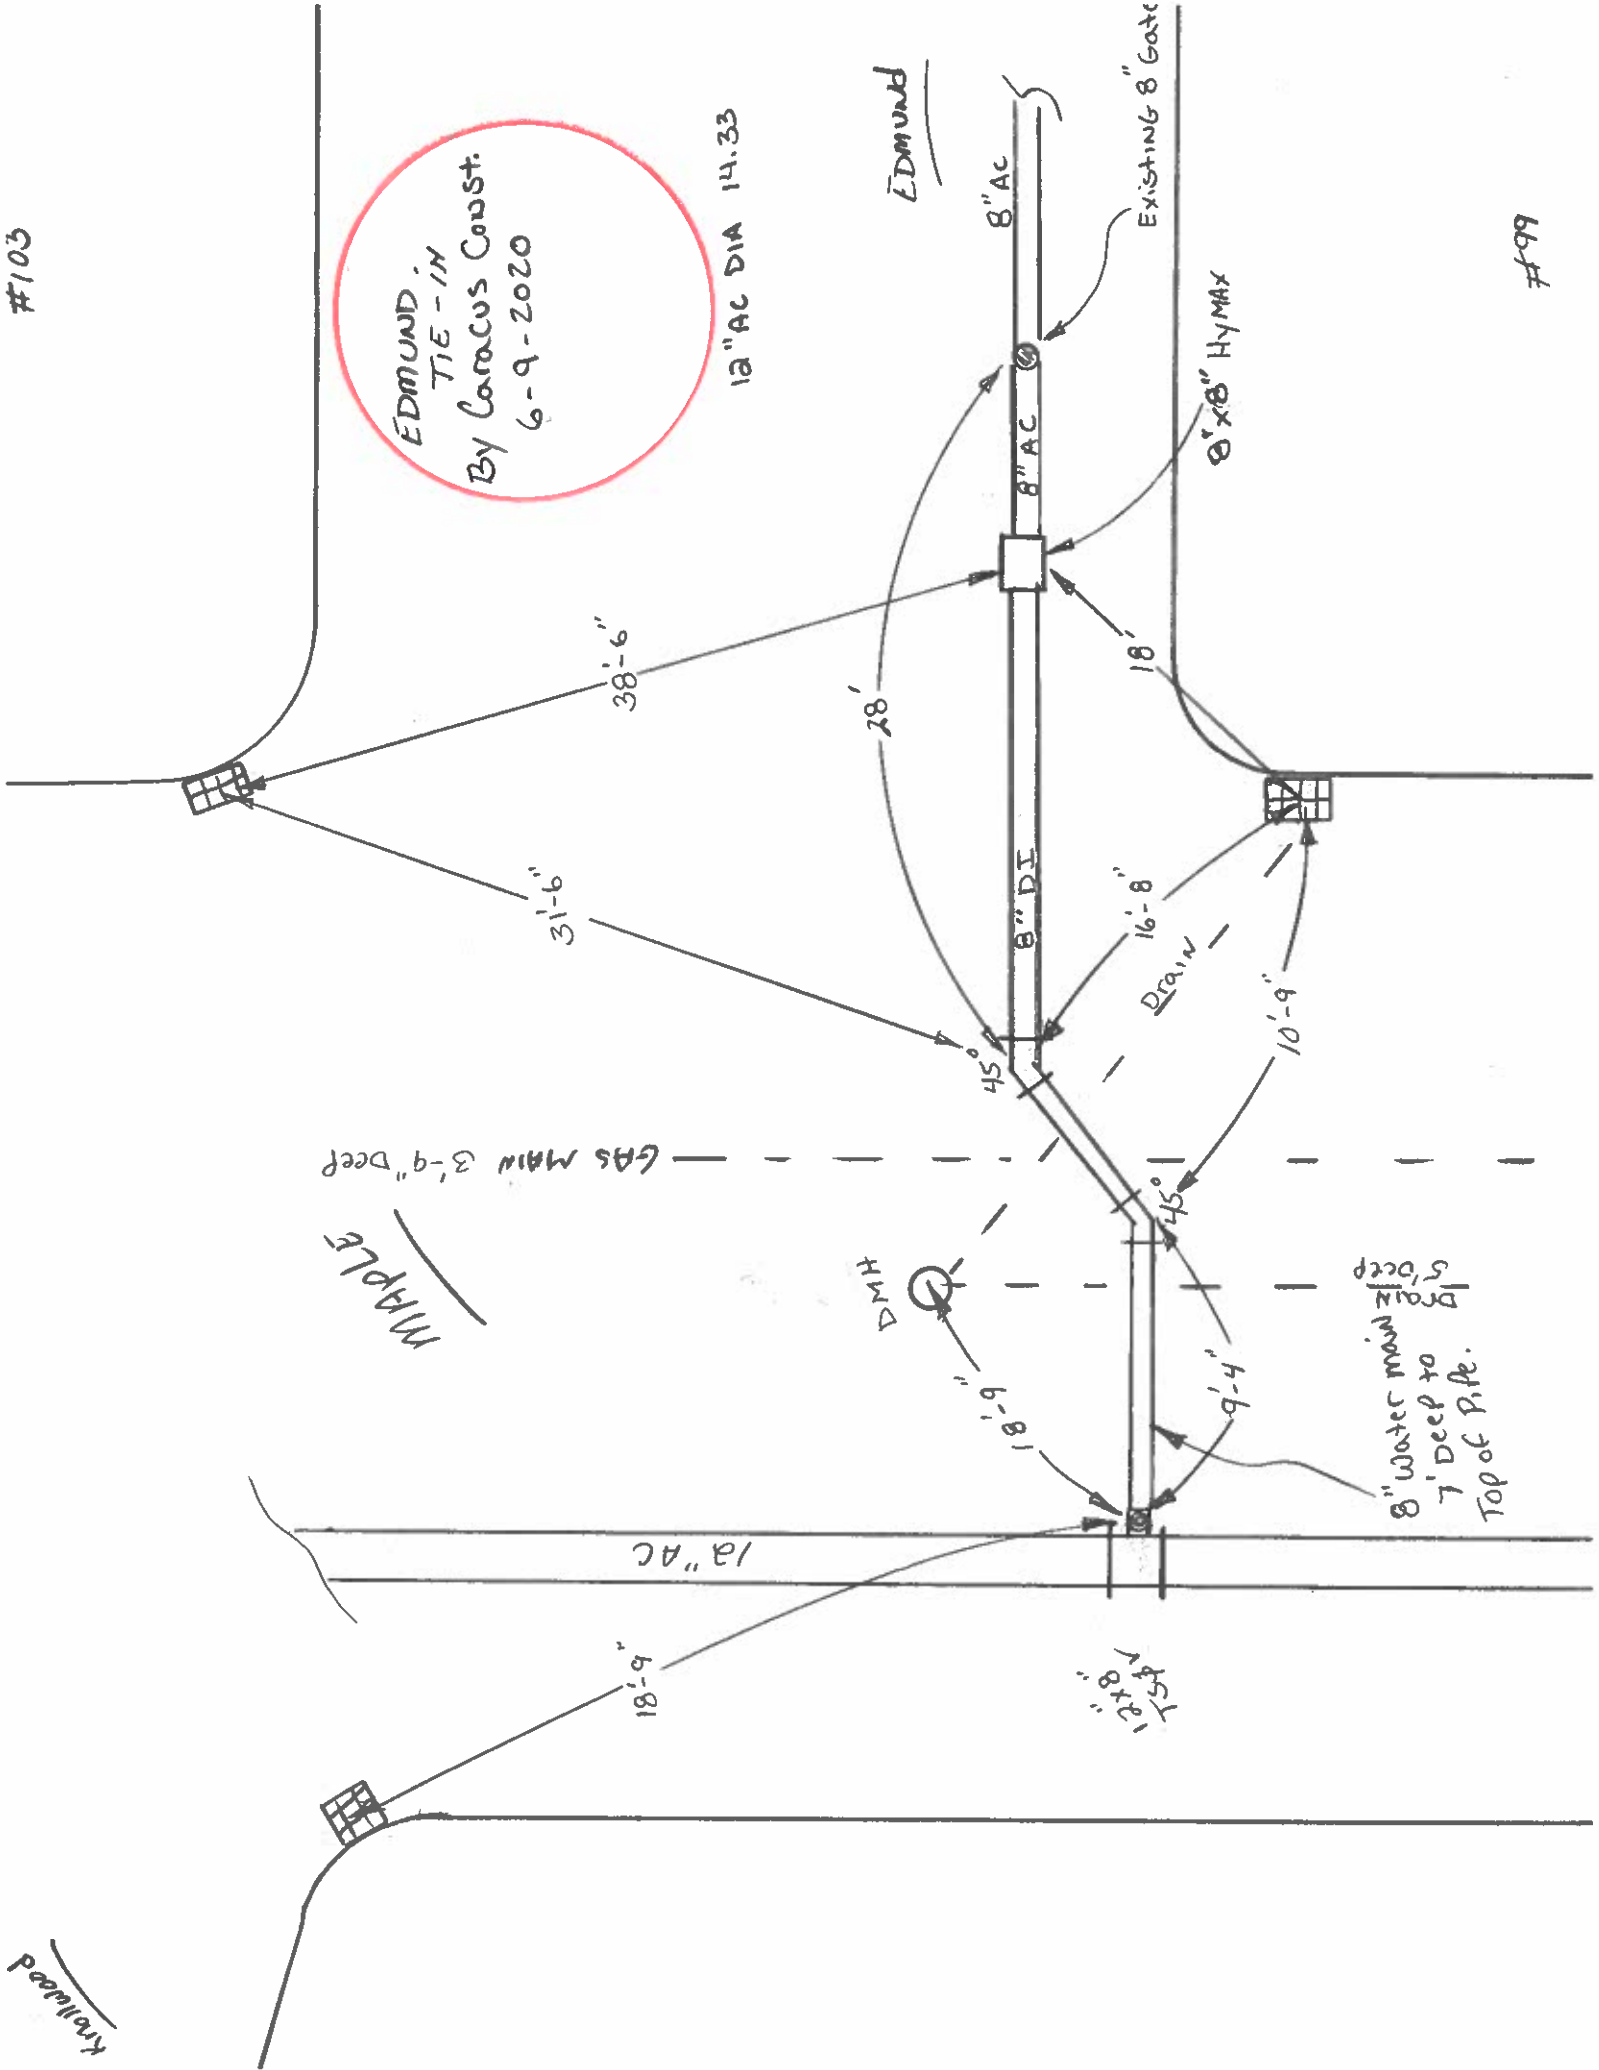

MAPLE

12" AC MAIN

12" x 8" TS3V
8" TAP T
VALVE @
45° - usable
NOT OPEN
LEFT OPEN

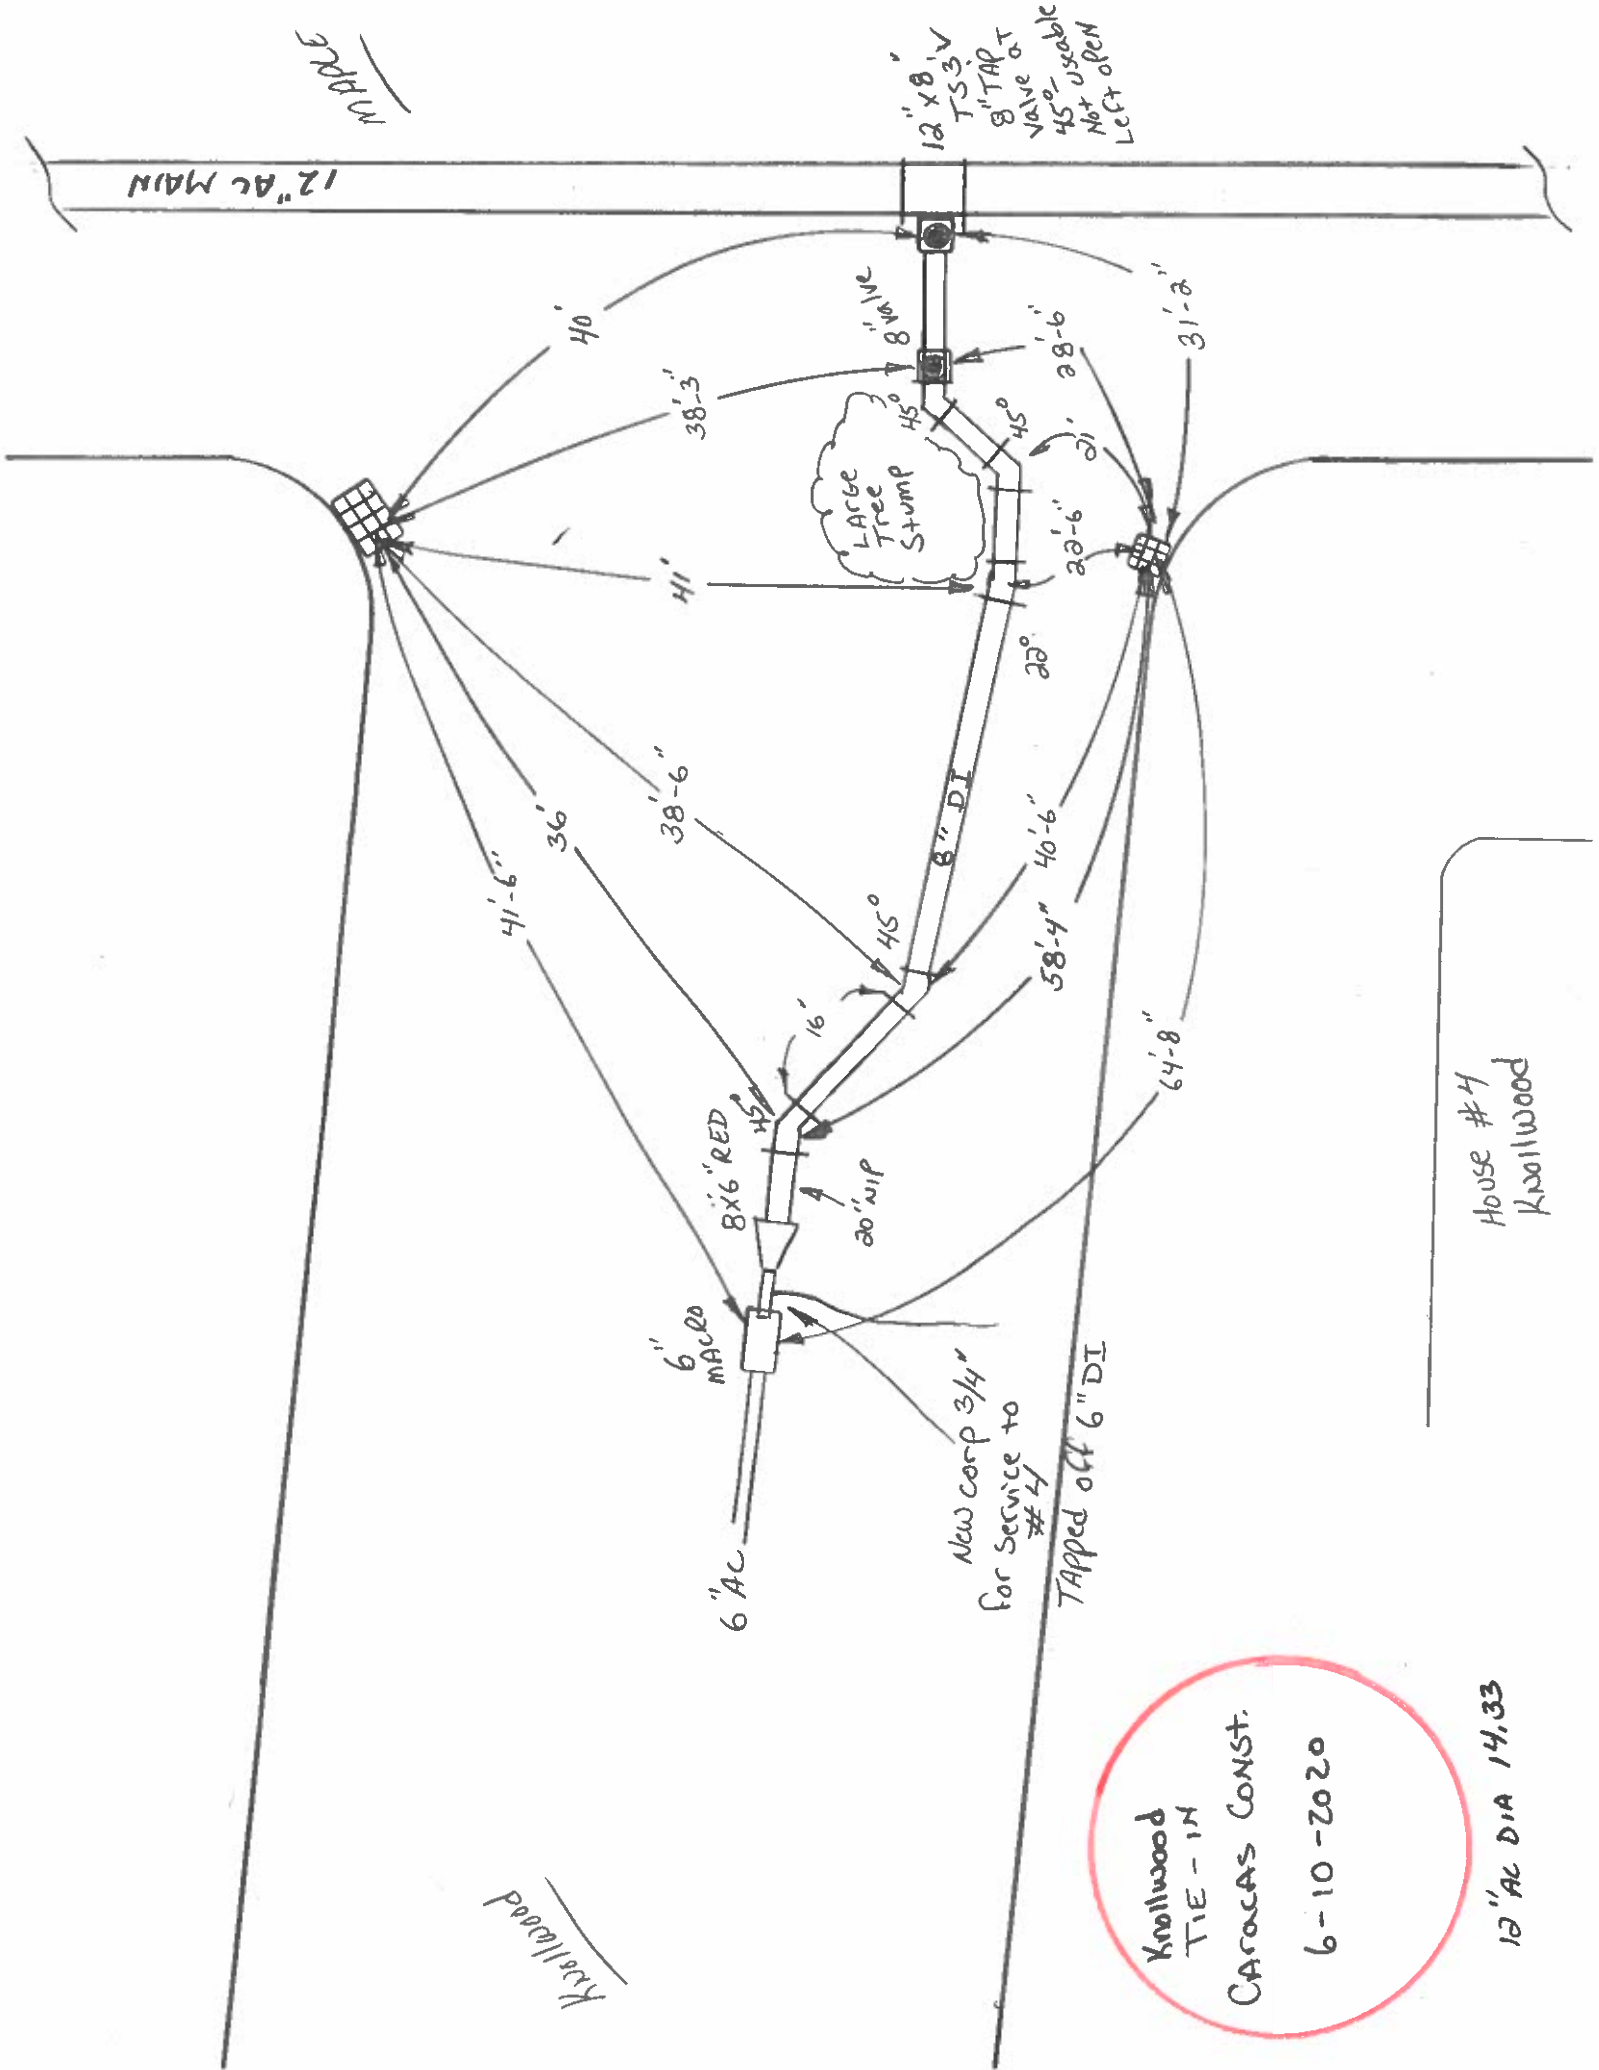

Knollwood

House #4
Knollwood

Knollwood
TIE - 1M
CARACAS CONST.
6-10-2020

12" AC DIA 14.33

Knollwood tie-in
By Caracas Const.

6-10-2020

Very Large Tree Stamp found
could not remove

6'

12" AC MAIN
is 7' deep to
Top of Pipe


8" Gate Valve


12" AC

Tapping valve at 45° angle
"OPEN" & buried
Not Accessable

FASTER Adapter
& 45° Bend East.

6" CI MAIN
To be Abandoned

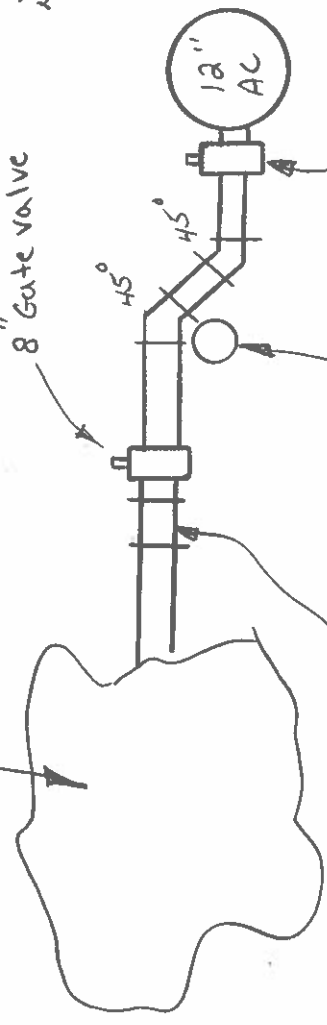

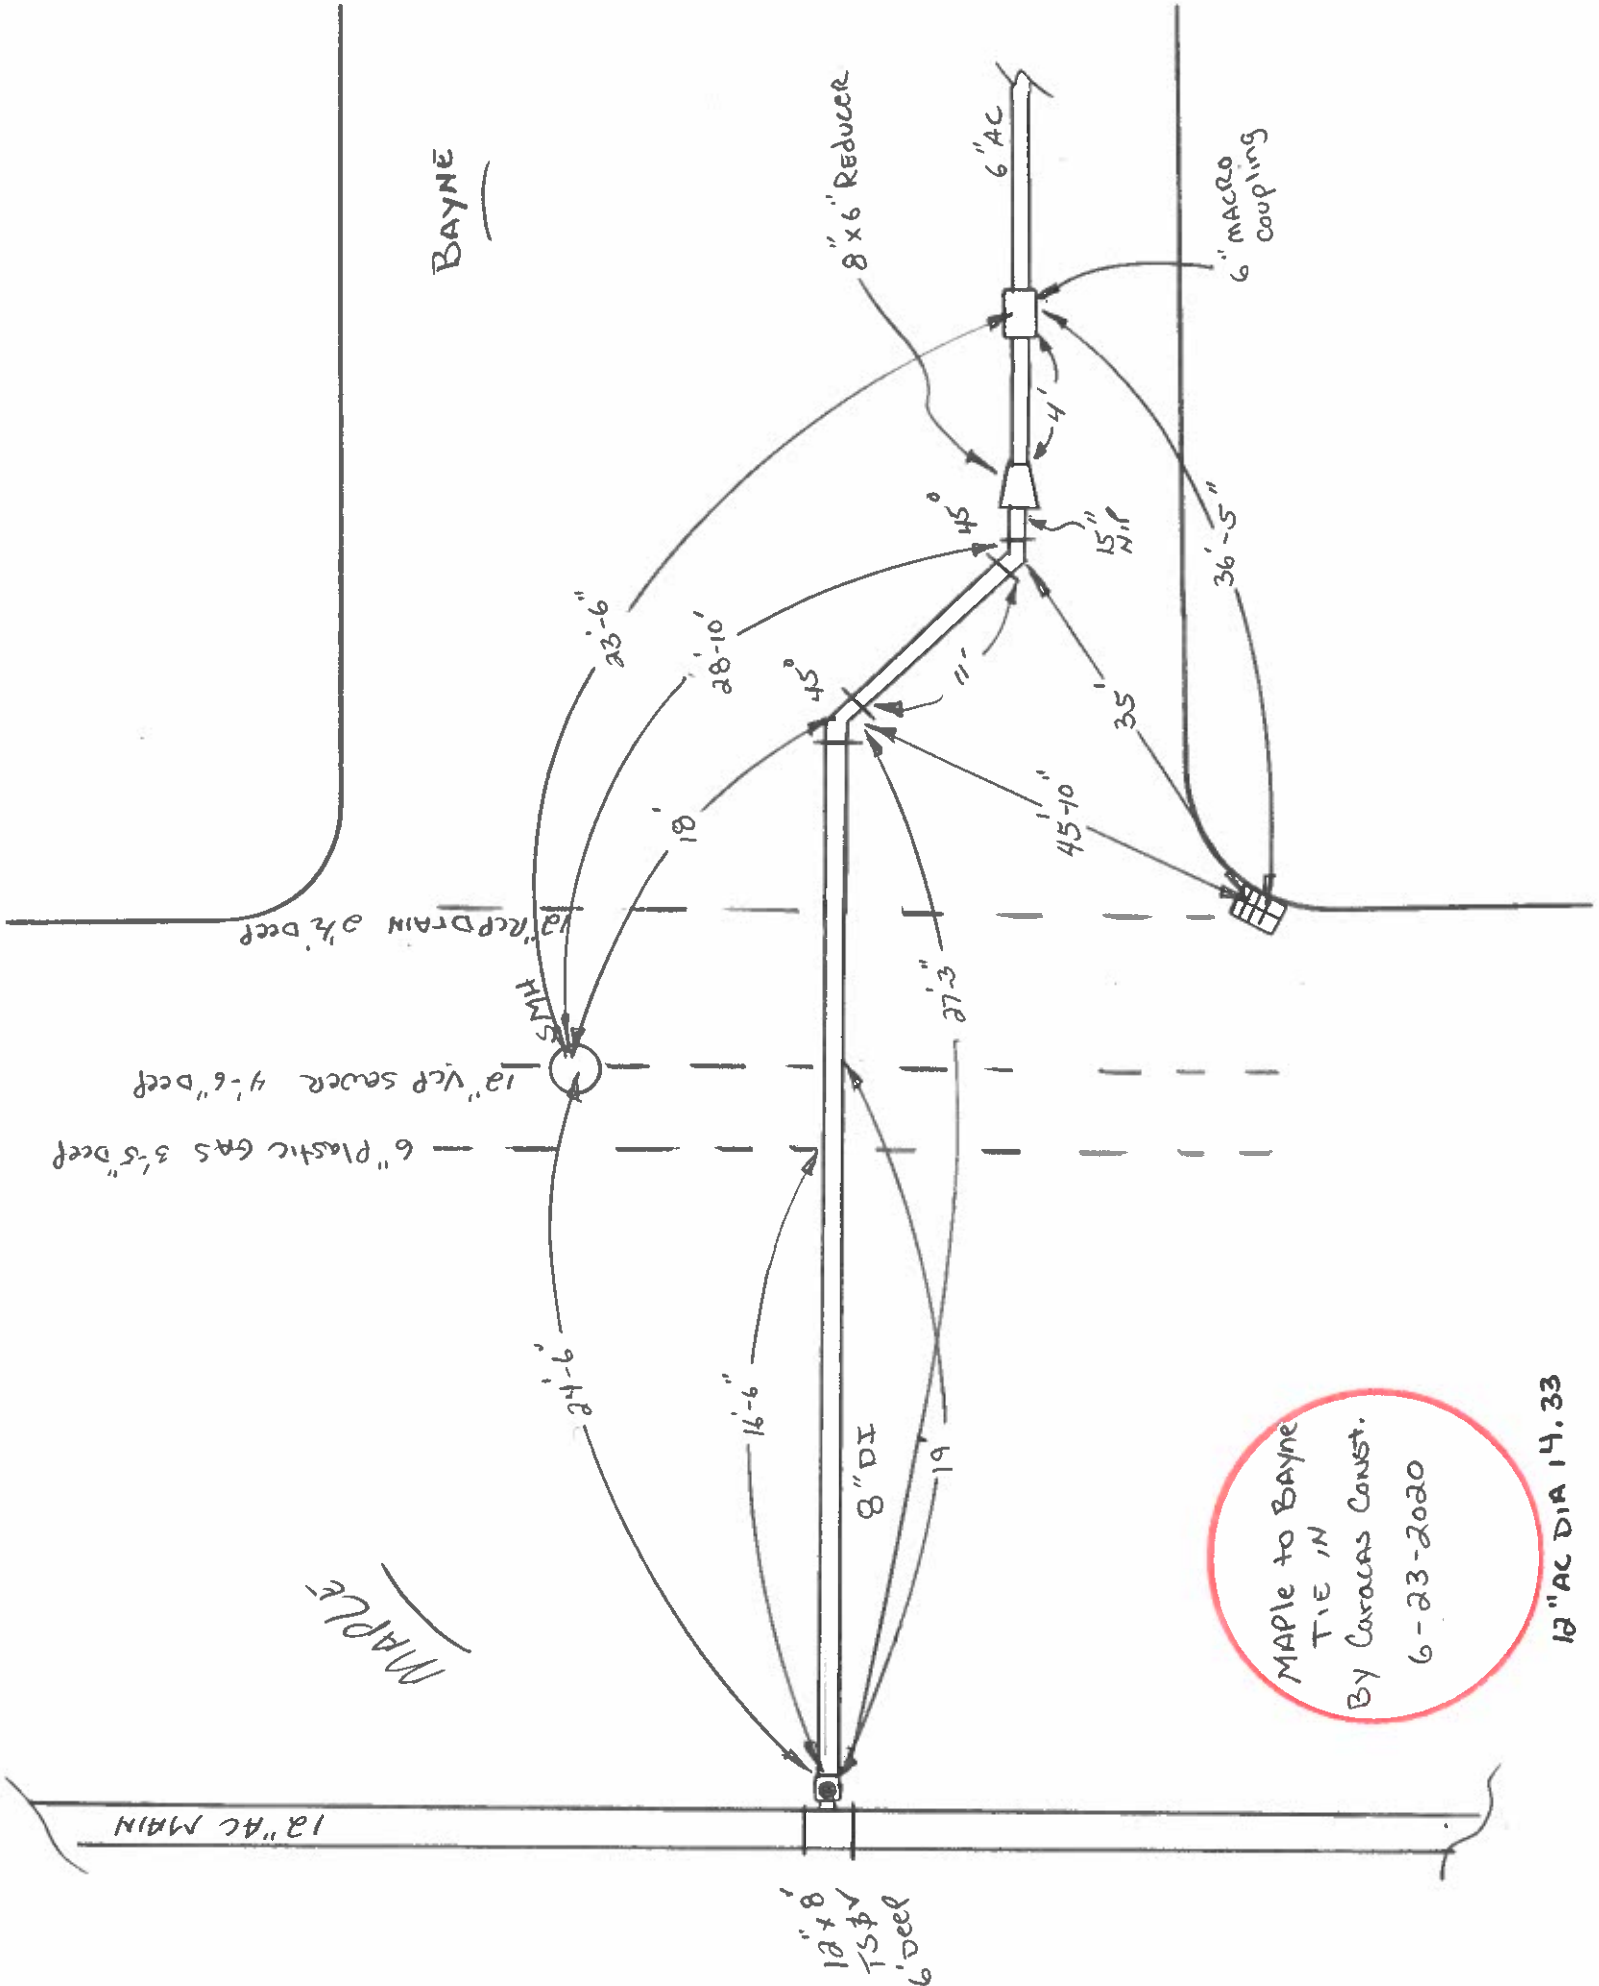


BAYNE

MAPLE

MAPLE to Bayne
TIE IN
By Caracas Const.
6-23-2020

12" AC DIA 14.33


MAPLE STREET

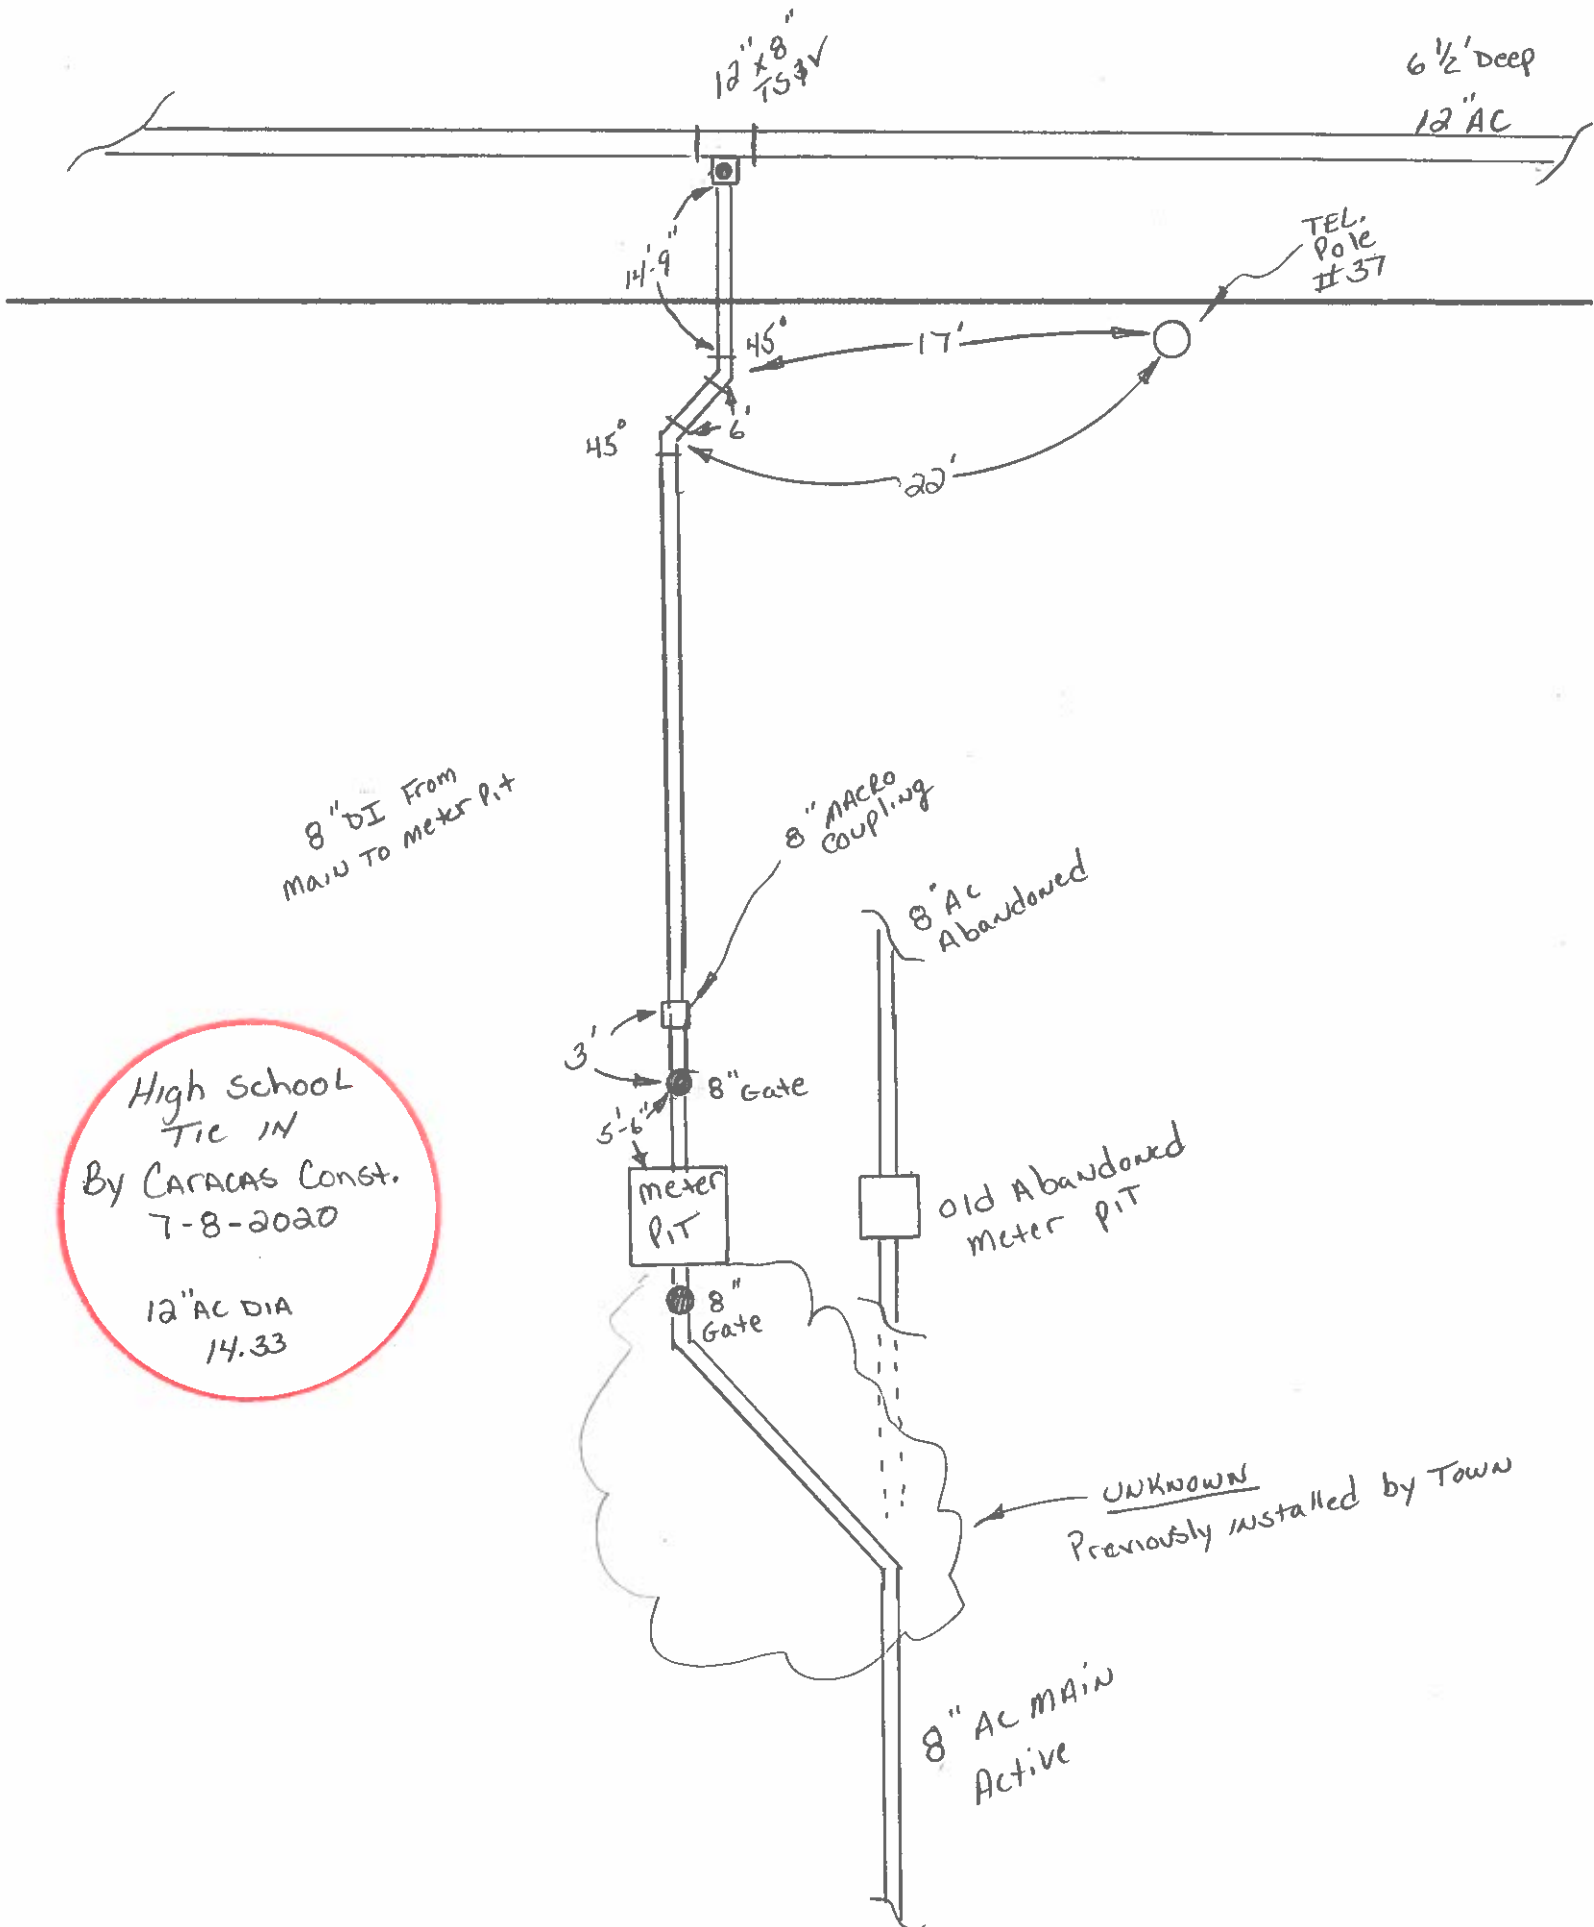

MELWOOD
TIE IN BY
CAROLAS CONST.
7-7-2020
12" AC DIA
14.33

MELWOOD

MAPLE

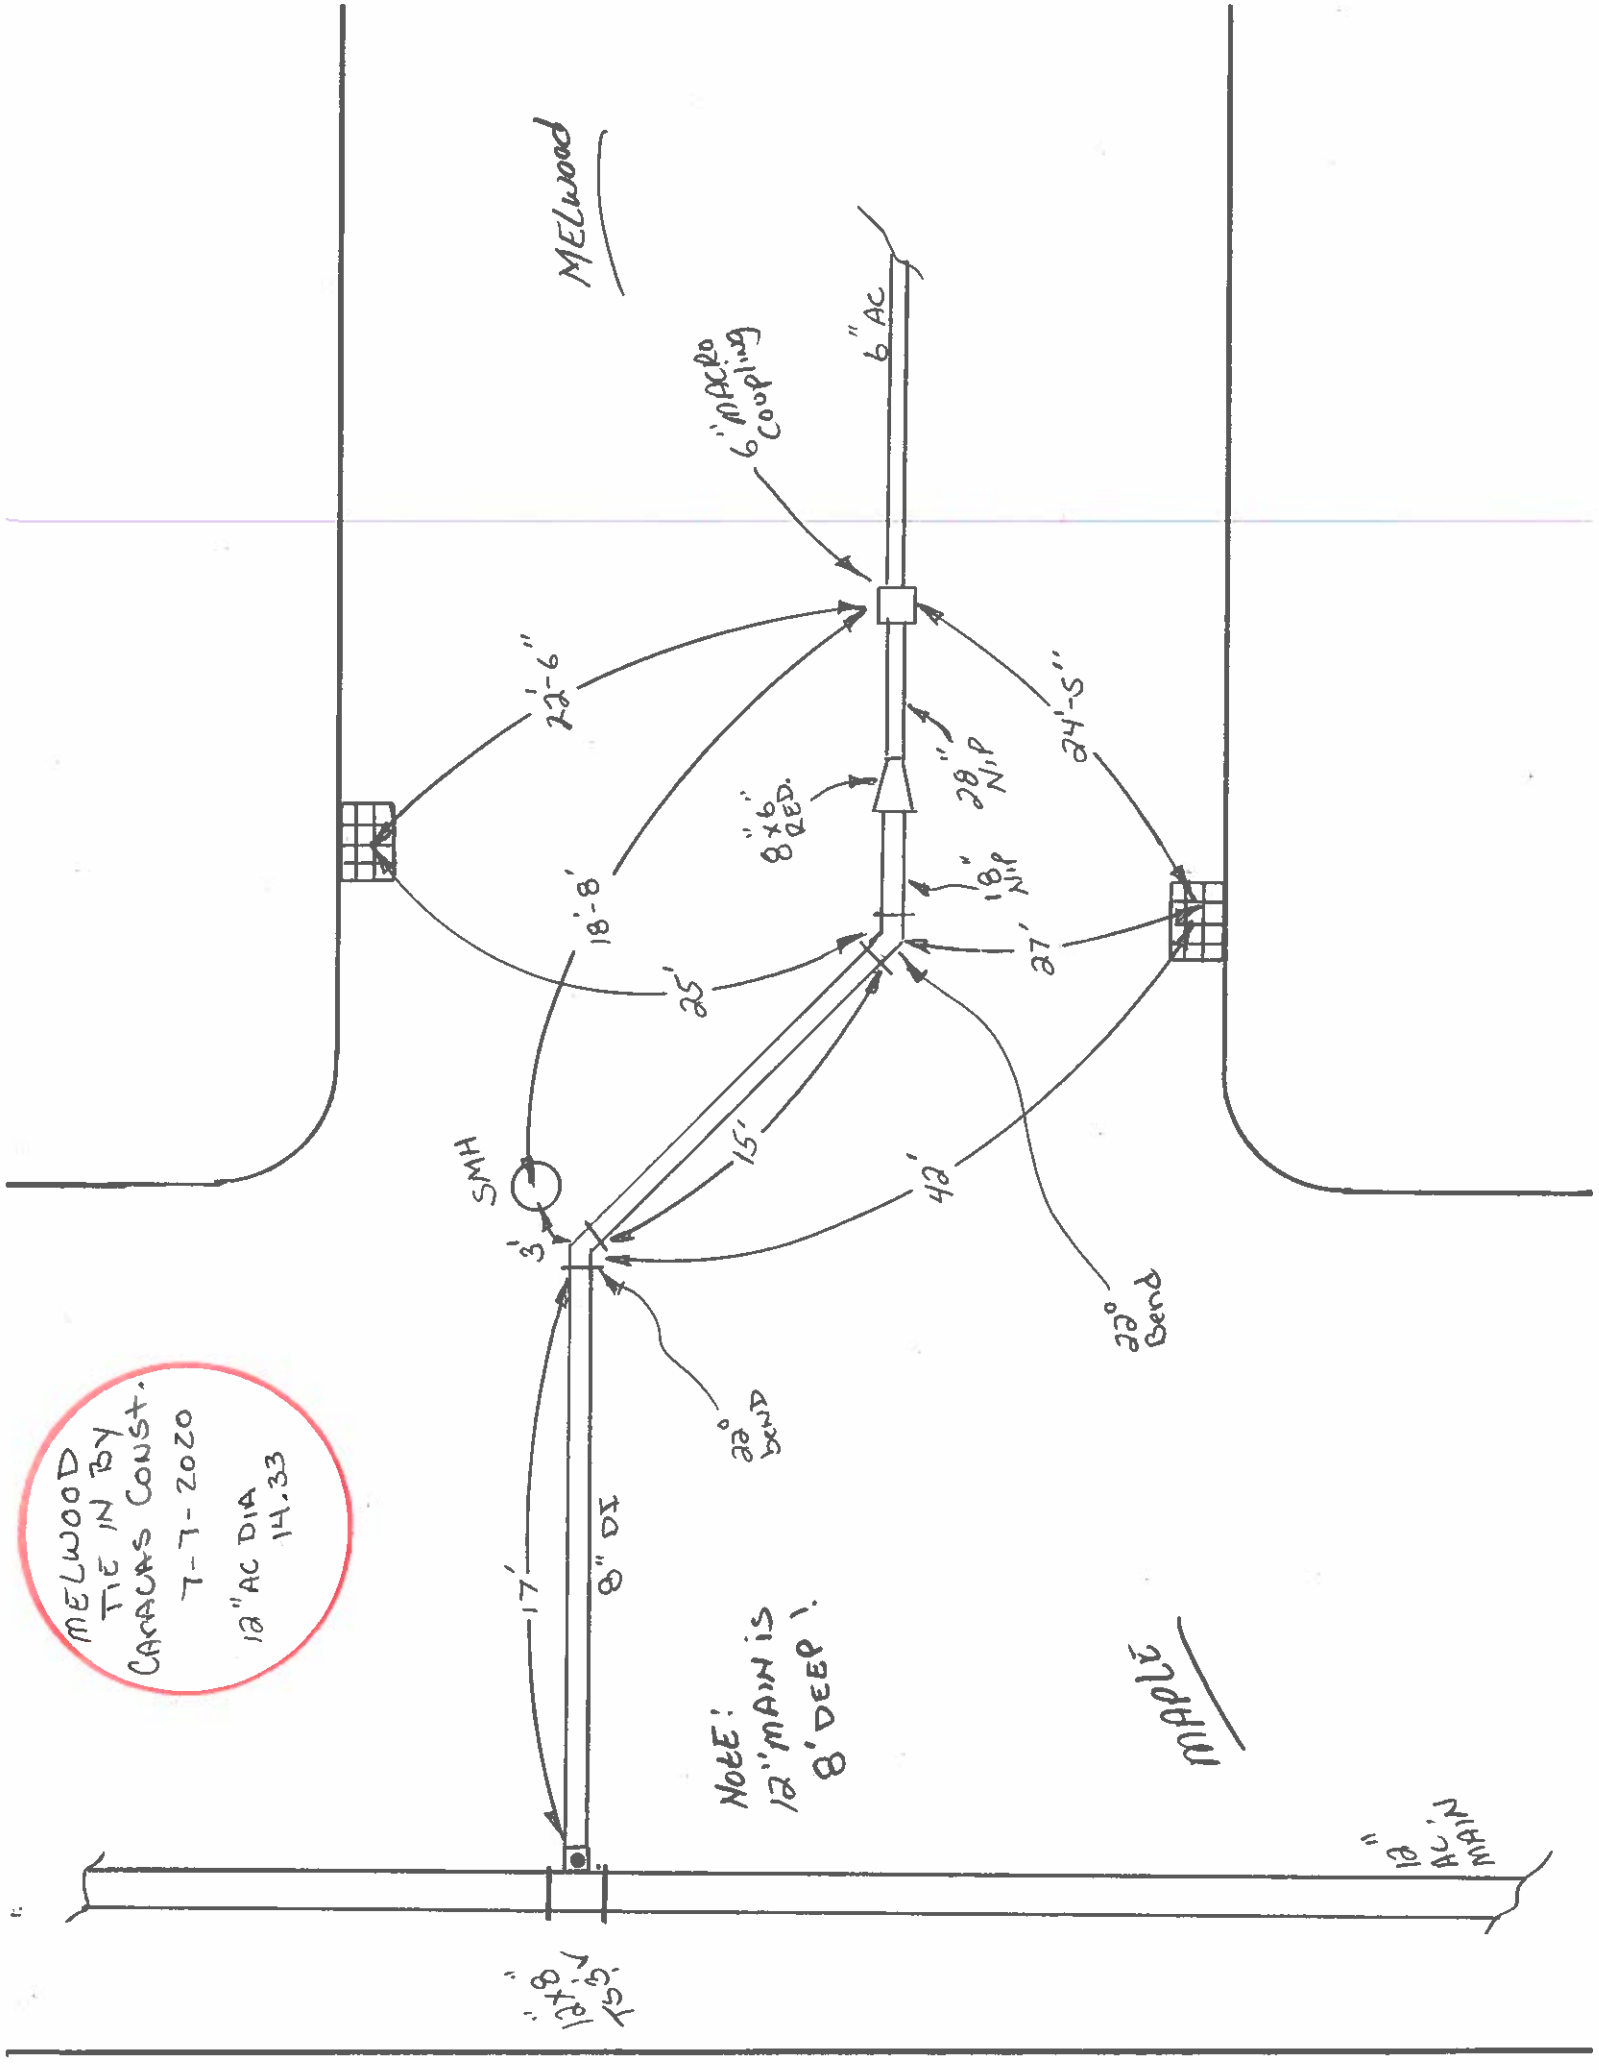

12" AC DIA MAIN