

Lot 10

NO. STREET:

DATE INST:

MAKE:


SIZE

5 MARCY LA,
42 Marci Ave.

8/19/76

Outside Badger

5/8"

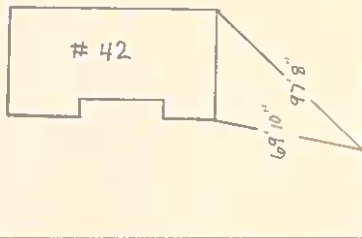

AMY LANE

MARCI AVE.