


NO. STREET

DATE INST.

MAKE:

SIZE

36 MARKHAM ROAD

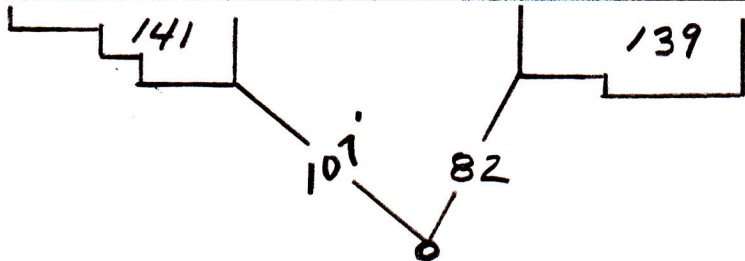

ALLEN STREET

CURB BOX FOR 36 MARKHAM RD.