

NO. STREET


DATE INST.

MAKE:

SIZE

82 MEADOWBROOK RD

10-6-10

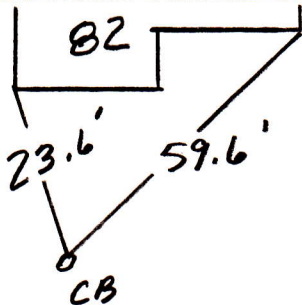

1" COPPER