


EAST LONGMEADOW DEPARTMENT OF PUBLIC WORKS

Job: Water Services

Sheet No: 30 meadowbrook rd of _____

Calculated By: _____ Date 2-22-17

Scale: R/E

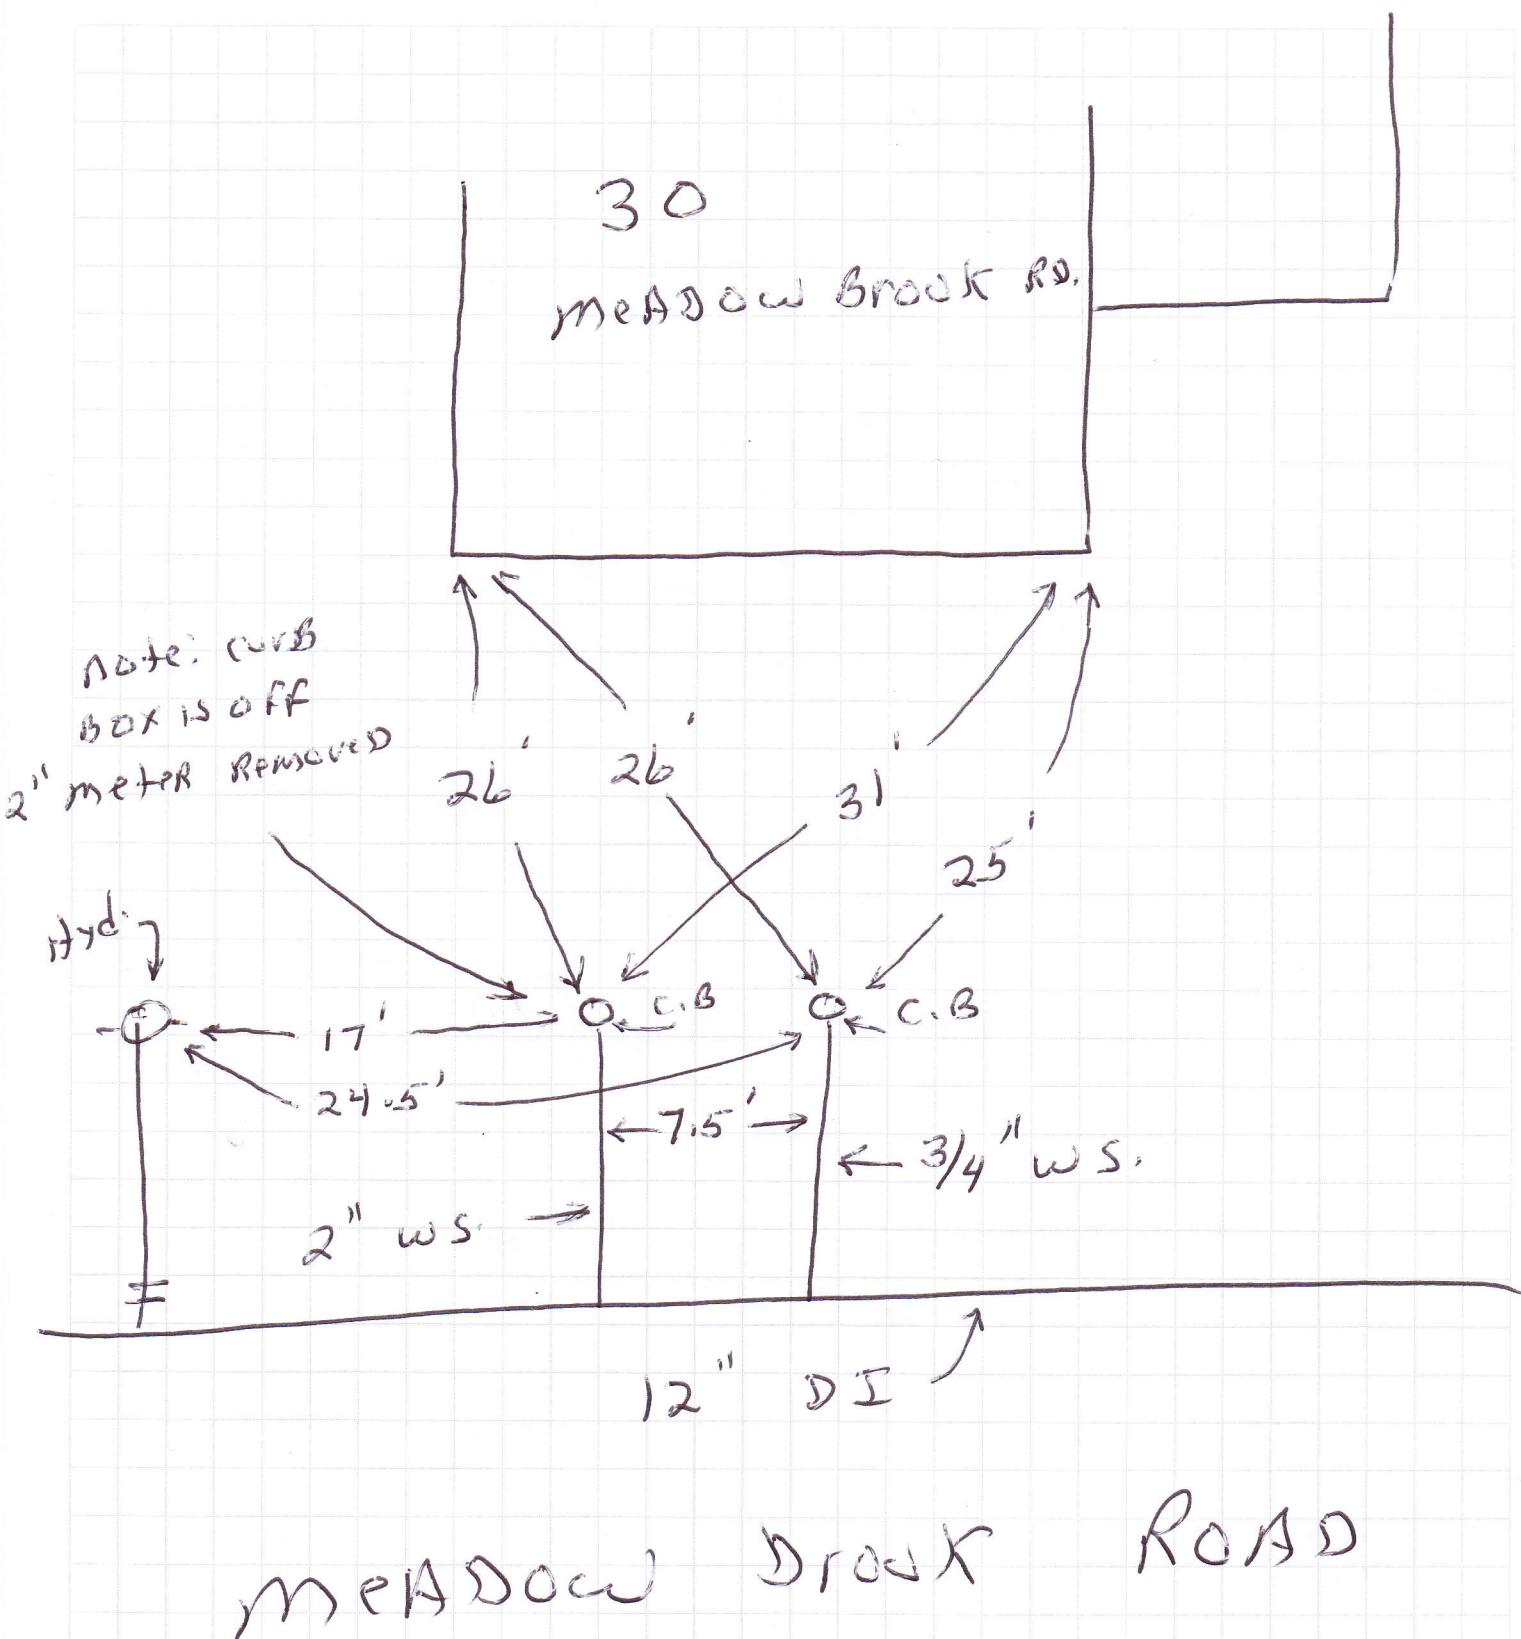

Note: curb
box is off
2" meter removed

Hyd.

26

26

31

25

17'

24.5'

← 7.5'

← $3/4$ " w.s.

2" WS. $\rightarrow$

12¹¹ DI

MEADOW BROOK ROAD