

WATER AND WASTEWATER SUPPLIES

Ti SALES


36 HUDSON ROAD
SUDBURY, MA 01776
978-443-2002

The Supply House That Knows How To Help

800-225-4616

Fax: 978-443-7600

www.tisales.com

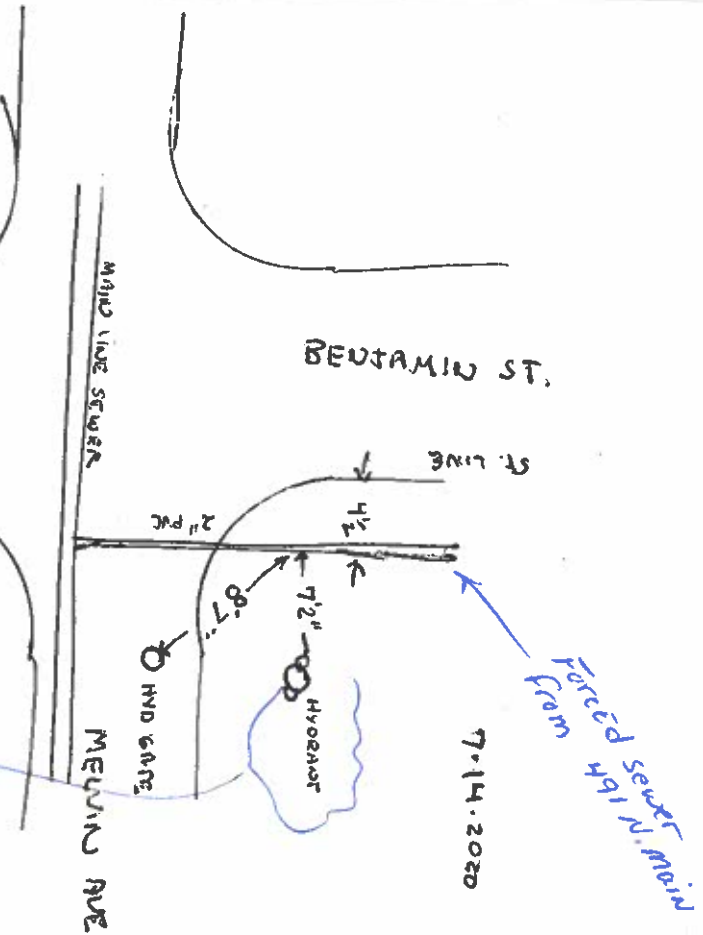

NEW HYDRAUT
installed 7-14-2020
waterous 250 6' by
8018 DARE
5'14" V0

NEPTUNE AMR & AMI Reading Technology • AVK Valves & Hydrants
FORD Brass Products, Meter Setters & Test Benches • REED Tools
SMITH-BLAIR Clamps & Couplings • LMI Chemical Feed Pumps
ZURN WILKINS Backflow Preventers • VAL-MATIC Check Valves
SCALETRON Drum, Tank & Platform Scales • SCHONSTEDT Magnetic Locators
CARUS Corrosion Control Chemicals • CLA-VAL Control Valves • Gate Boxes
FERNCO • CRETEX ProRings • CULTEC Stormwater Chambers • Pipe & Tubing