


MERRIAM STREET - #14

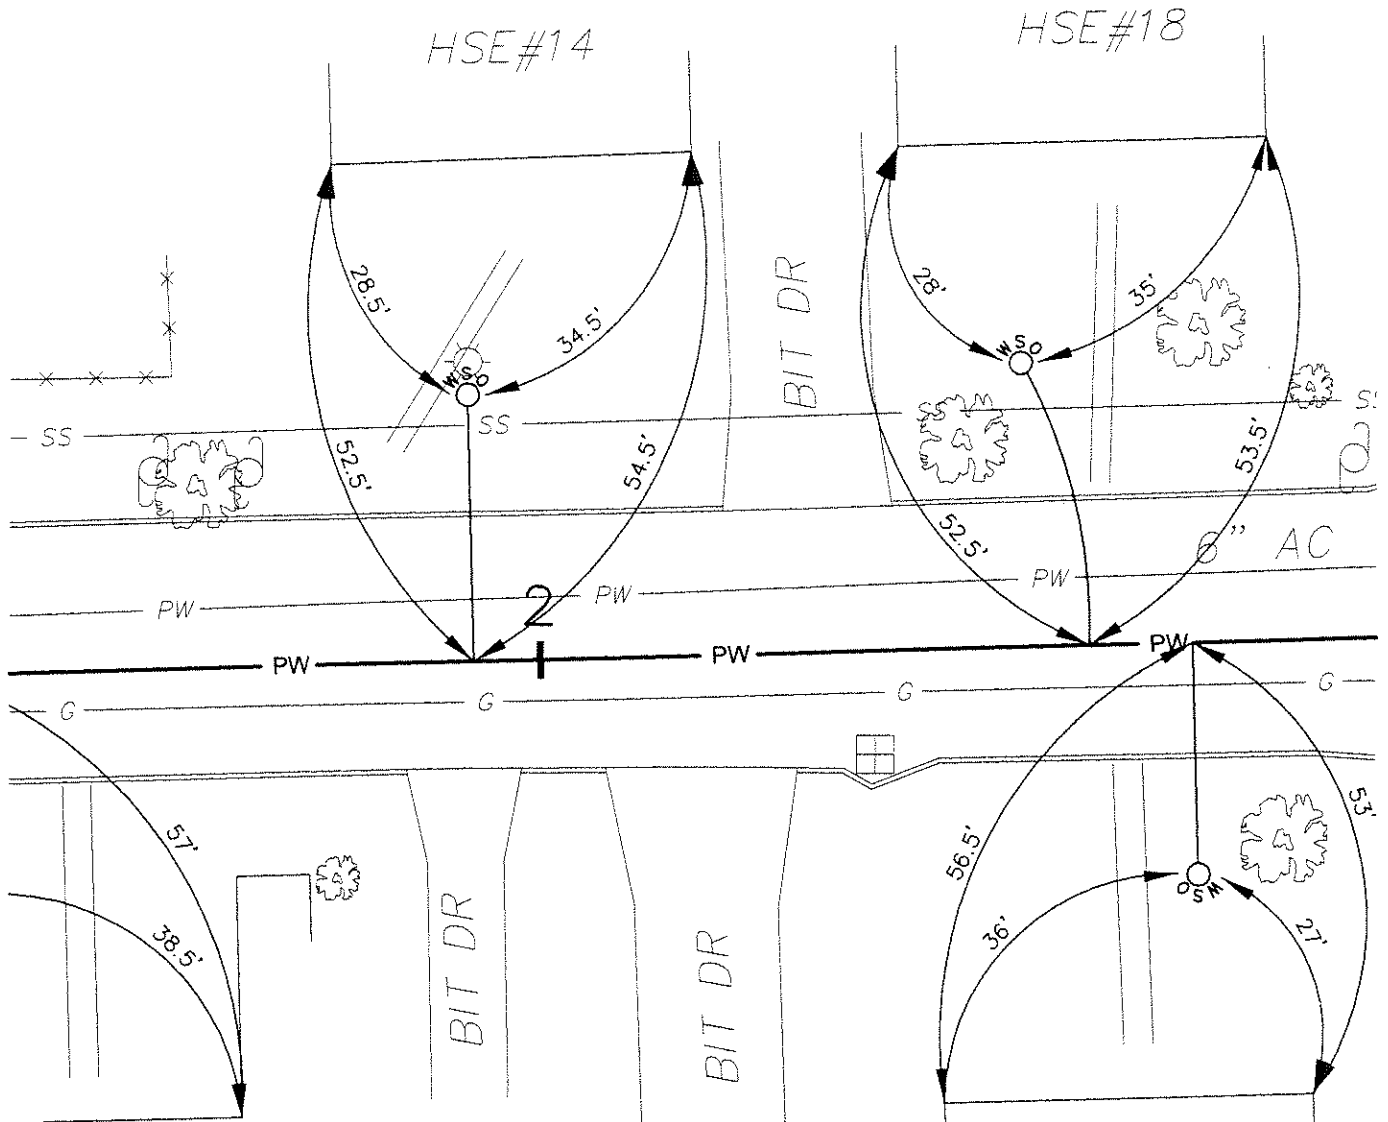

HOUSE SERVICE INFORMATION:

DEPTH AT MAIN: 5.5'
DEPTH AT PROPERTY LINE: 6'
DATE INSTALLED: 10/26/04

PREPARED BY TIGHE & BOND