


MERRIAM STREET - #15

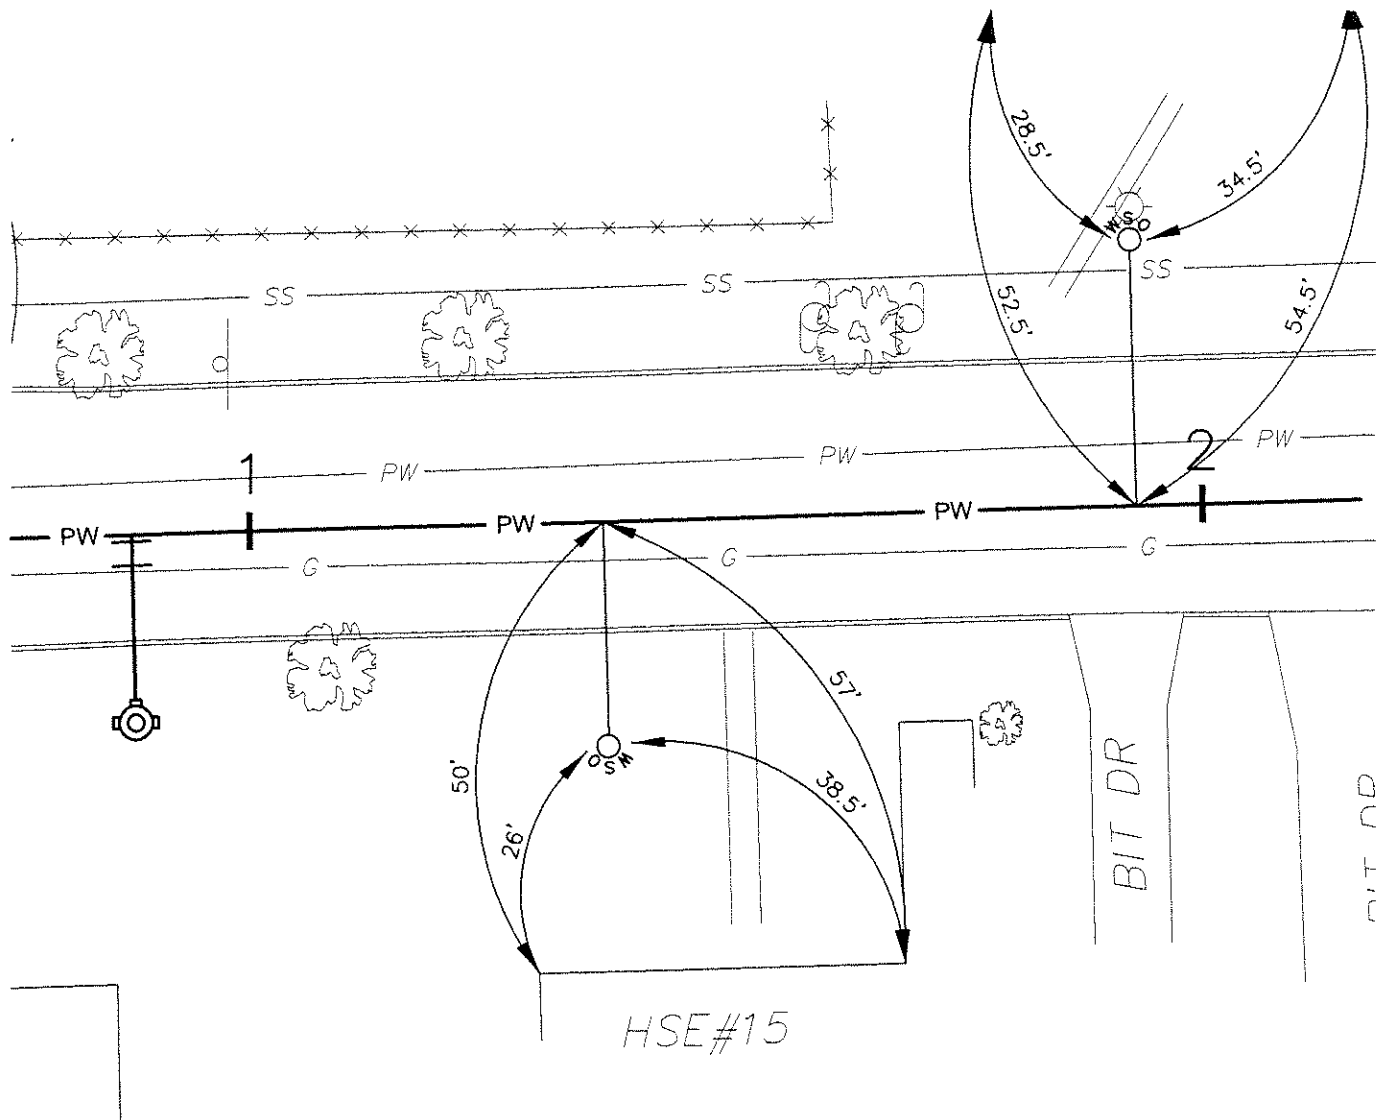

HOUSE SERVICE INFORMATION:

DEPTH AT MAIN: 5.5'
 DEPTH AT PROPERTY LINE: 5'
 DATE INSTALLED: 10/26/04

PREPARED BY TIGHE & BOND