


# MERRIAM STREET - #40

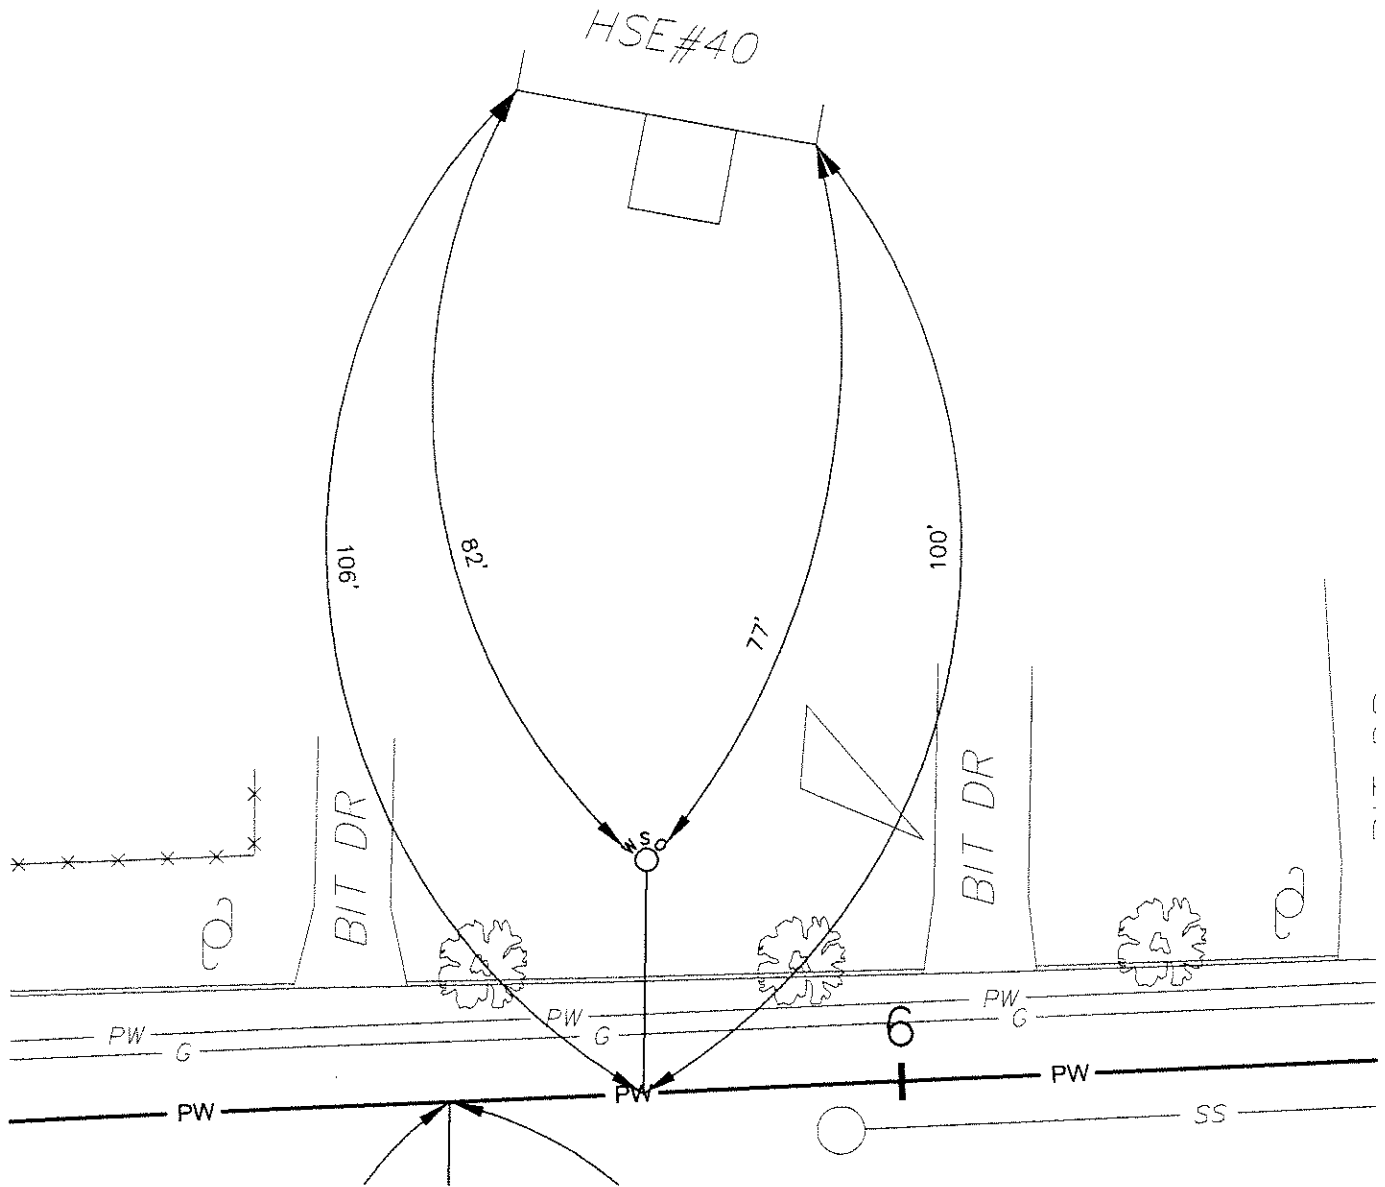

## HOUSE SERVICE INFORMATION:

DEPTH AT MAIN: 6'  
DEPTH AT PROPERTY LINE: 6'  
DATE INSTALLED: 10/27/04

PREPARED BY TIGHE & BOND