


# MERRIAM STREET - #57

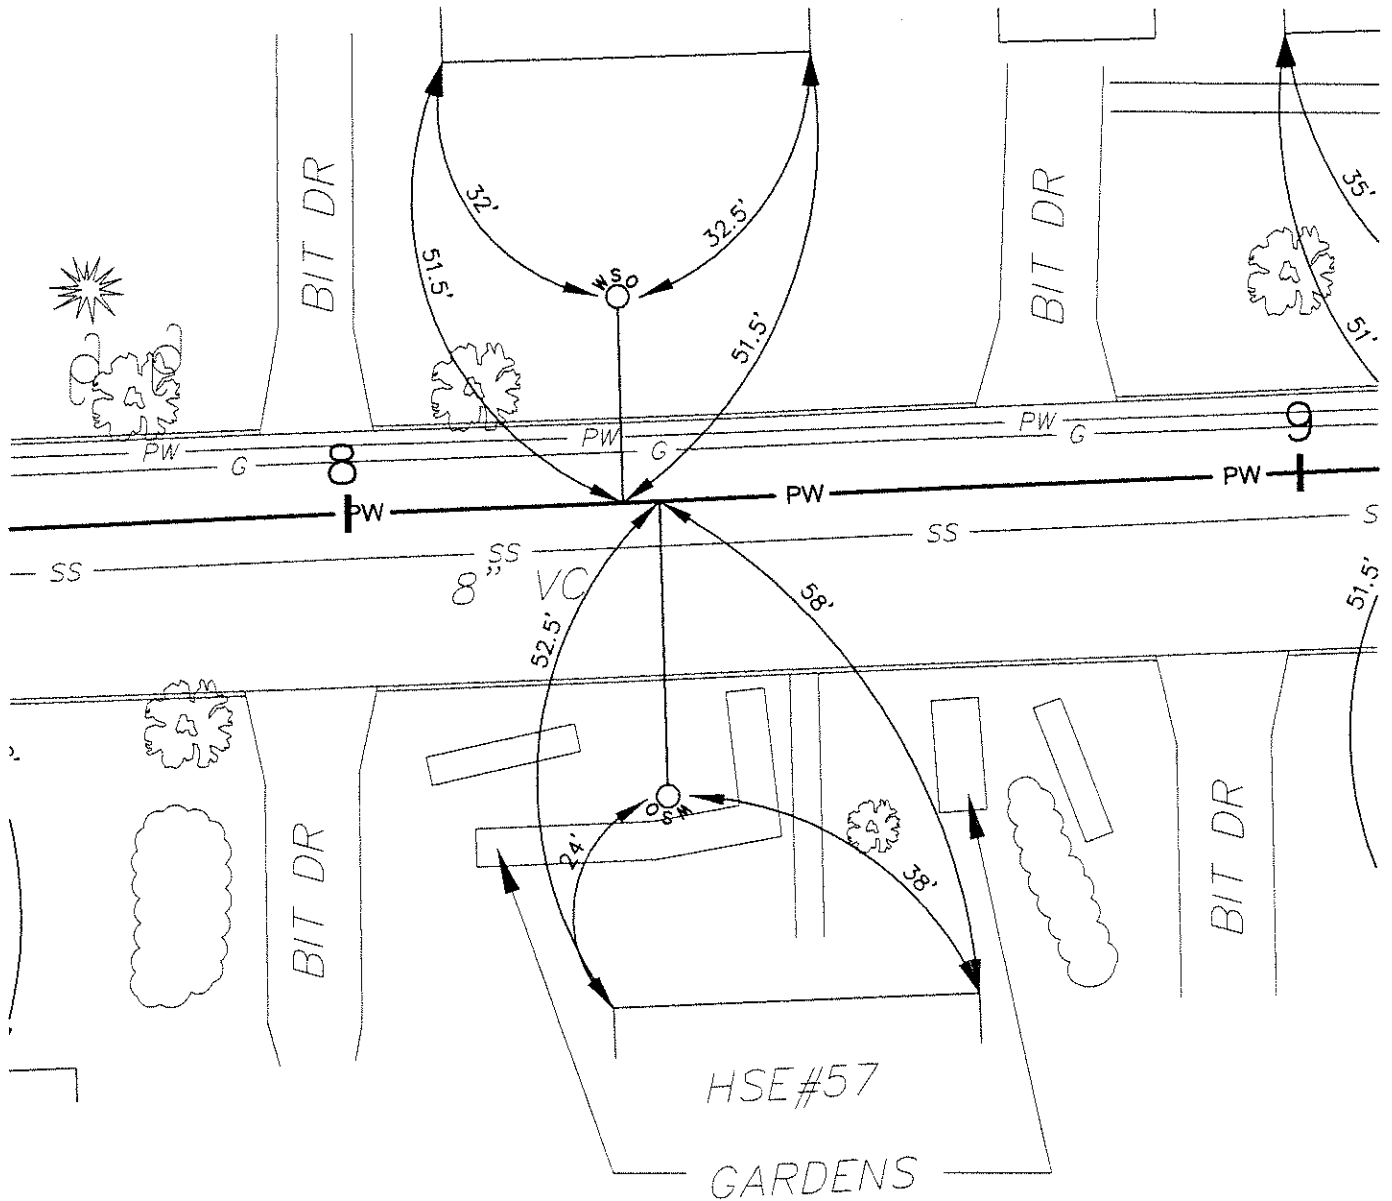

## HOUSE SERVICE INFORMATION:

DEPTH AT MAIN: 6.5'  
 DEPTH AT PROPERTY LINE: 6'  
 DATE INSTALLED: 11/02/04

PREPARED BY TIGHE & BOND