


MERRIAM STREET - #61

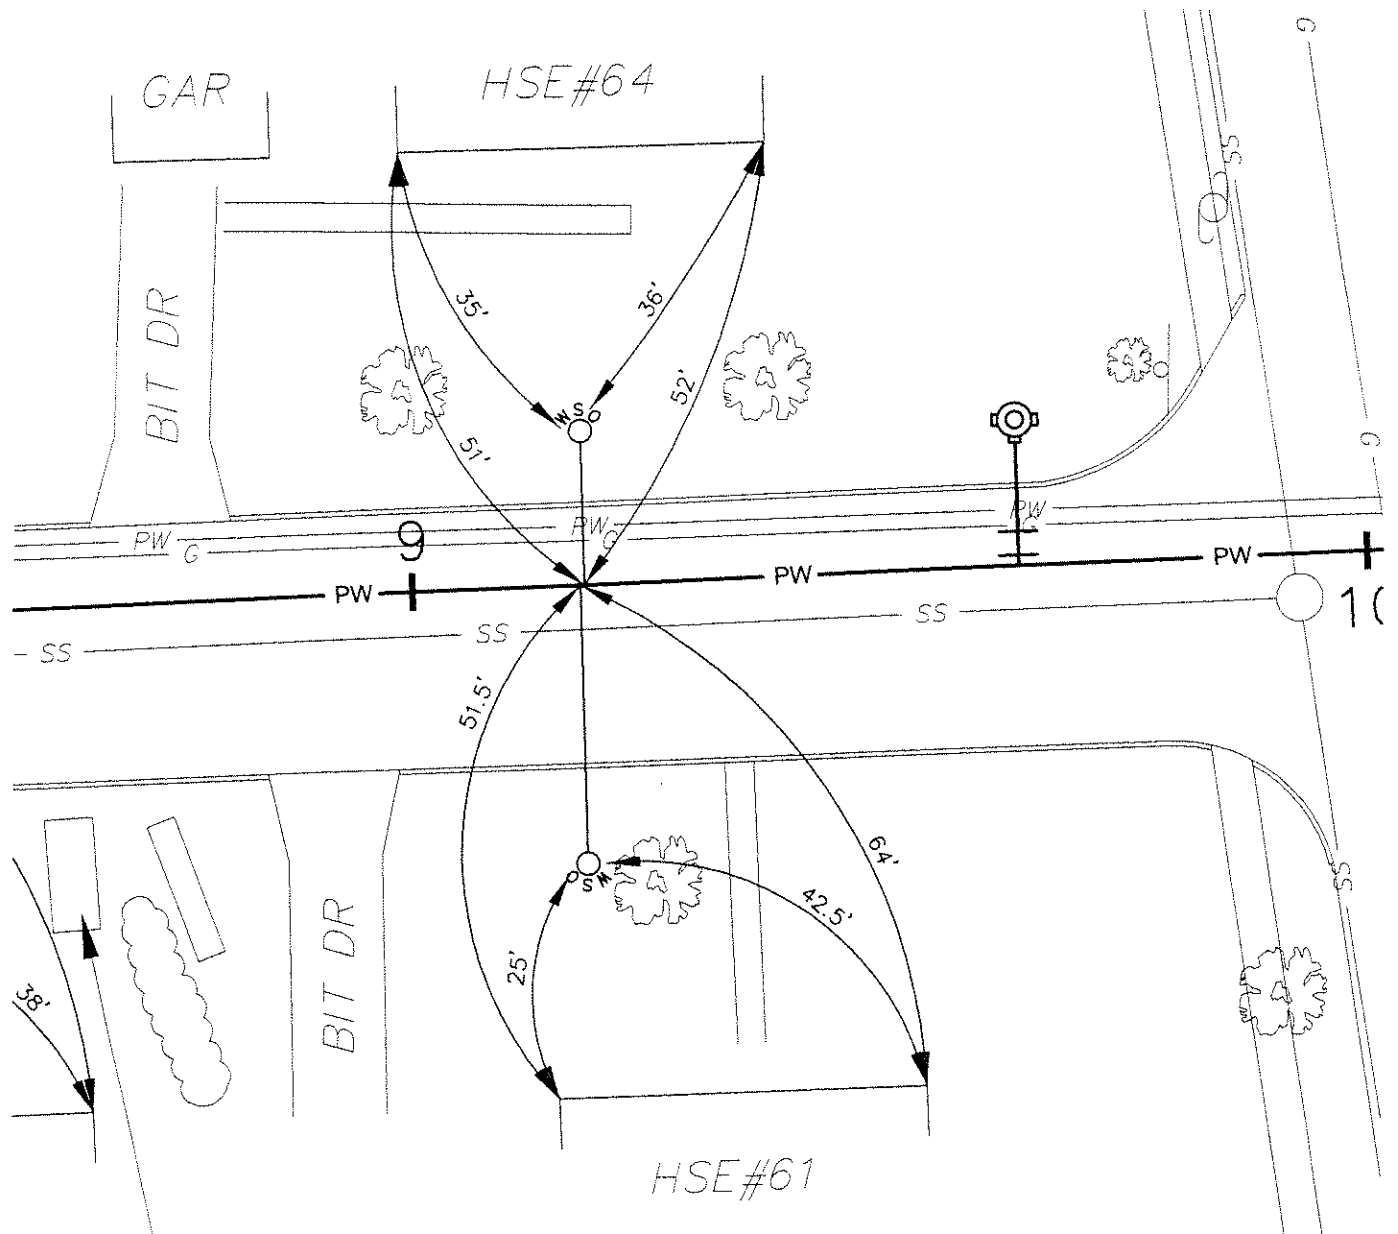

HOUSE SERVICE INFORMATION:

DEPTH AT MAIN: 6.5'
DEPTH AT PROPERTY LINE: 6'
DATE INSTALLED: 11/02/04

PREPARED BY TIGHE & BOND