


#33 M.I. Road

#38

Driveway

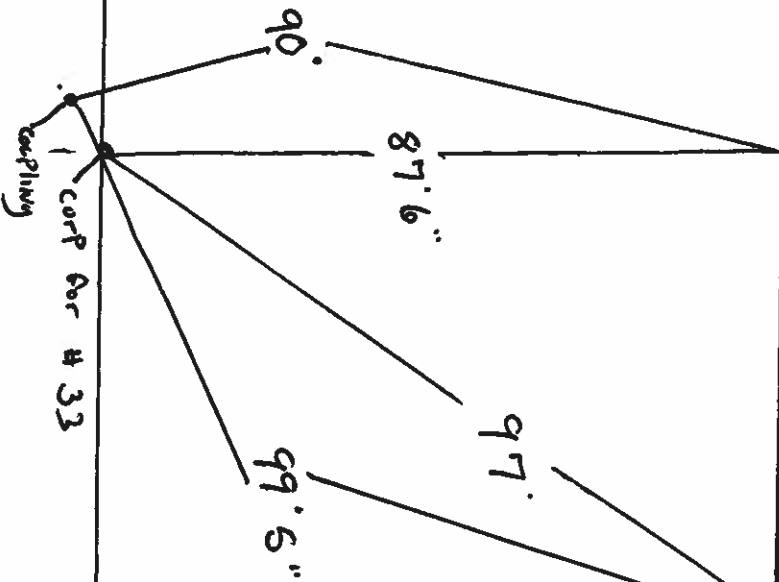

Driveway
for #33

6 curb stop for #33

M.I. RD

#30

SADDLE Replaced 4-20-20
1" corp.
1" C+SP m-c

Service is tagged off
Back side of main and then
looped over water main to
Service #33