


MURRAY COURT - #4

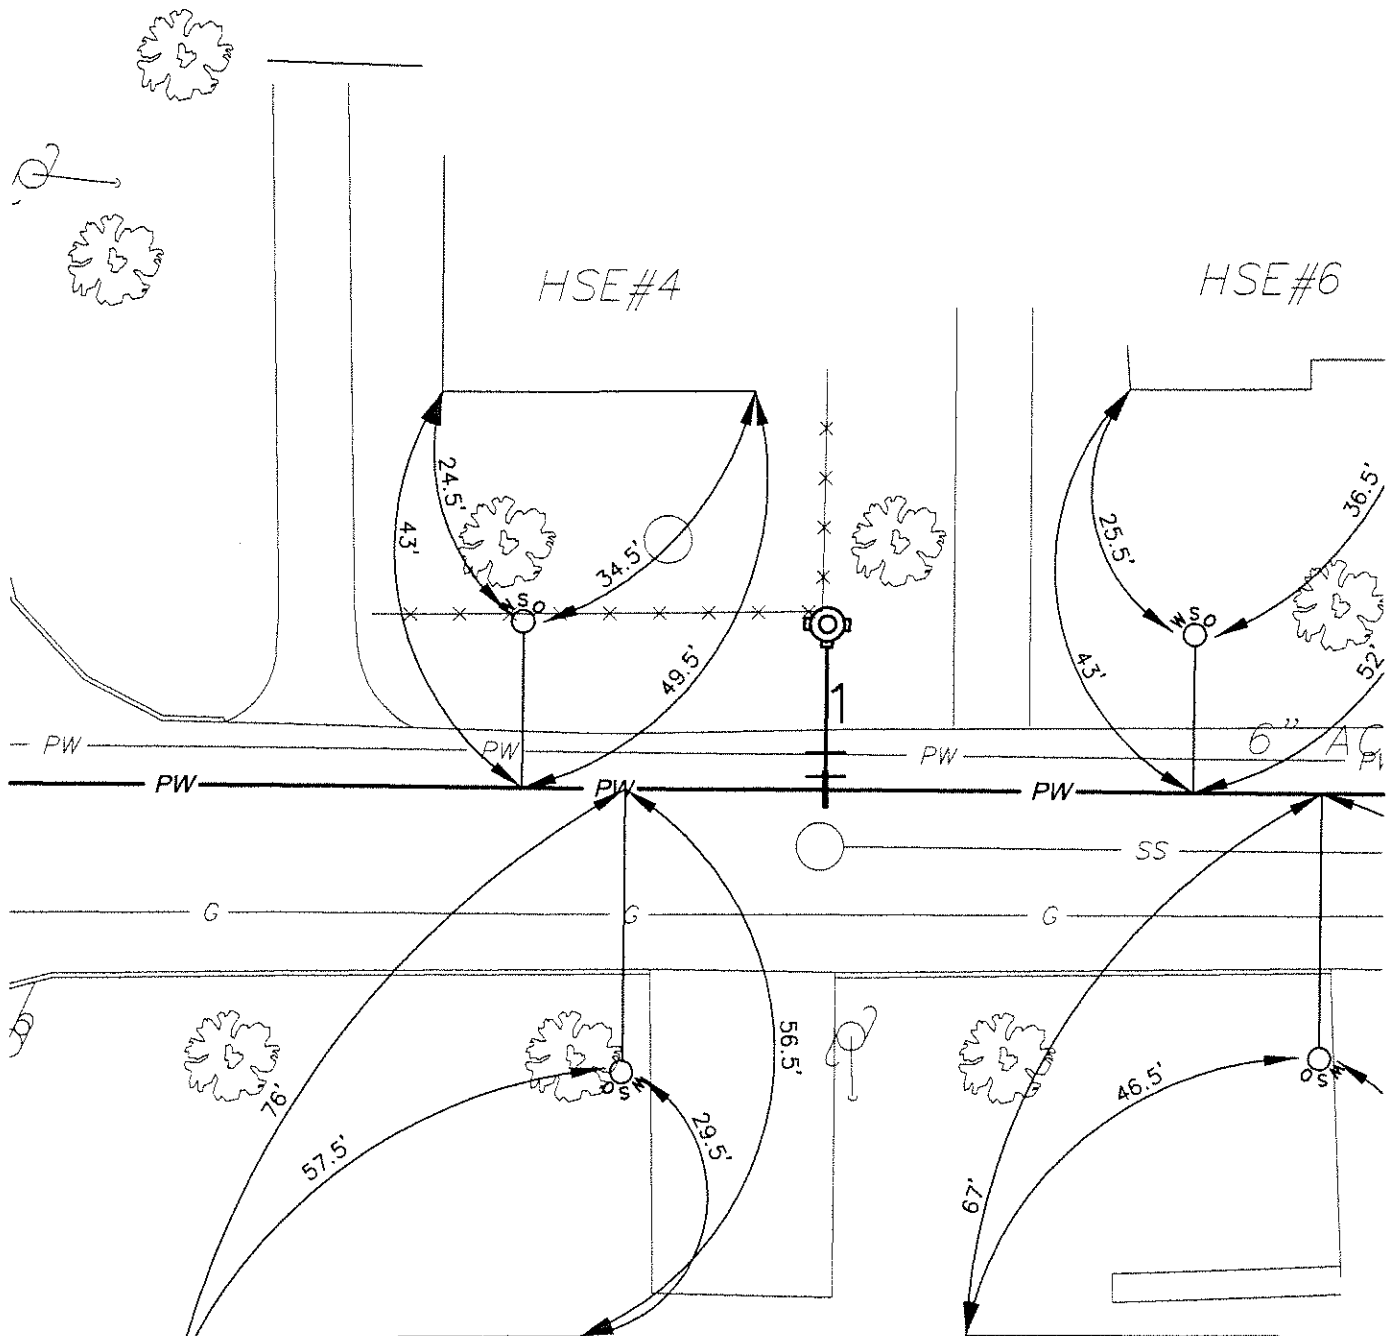

HOUSE SERVICE INFORMATION:

DEPTH AT MAIN: 5'
DEPTH AT PROPERTY LINE: 5.5'
DATE INSTALLED: 10/04/04

PREPARED BY TIGHE & BOND