


# MURRAY COURT - #5

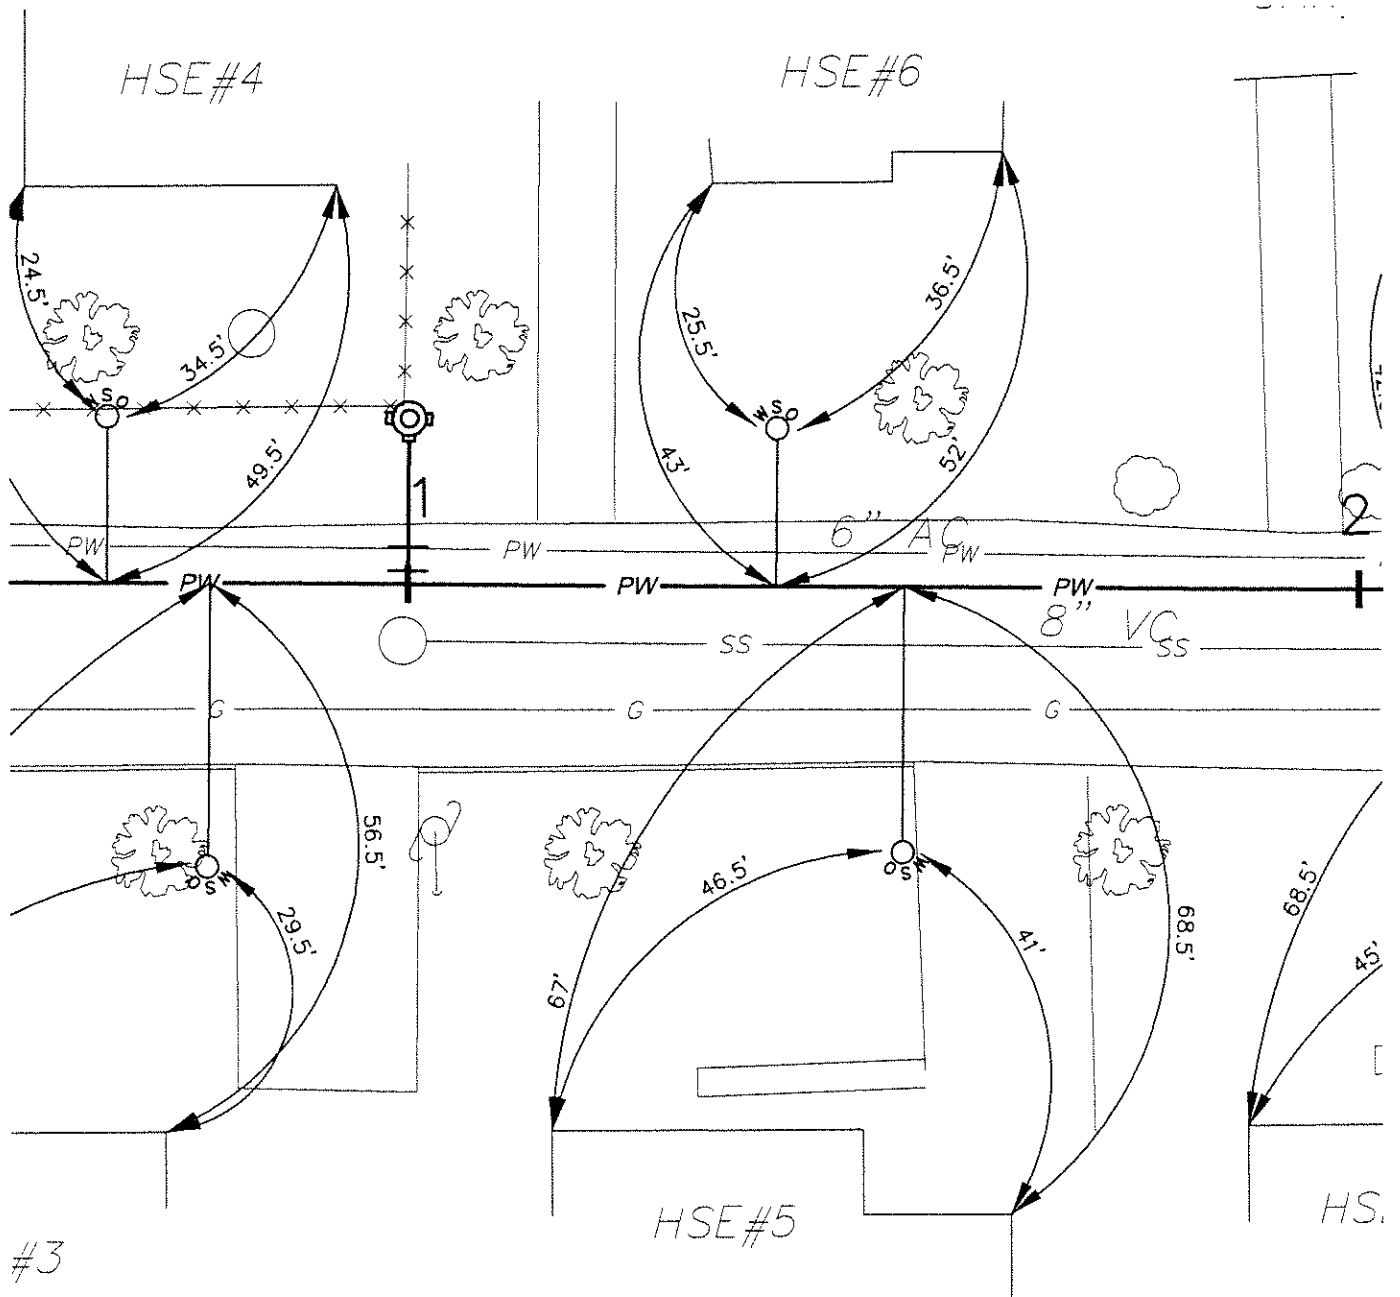

## HOUSE SERVICE INFORMATION:

DEPTH AT MAIN: 5'  
 DEPTH AT PROPERTY LINE: 5'  
 DATE INSTALLED: 10/04/04

PREPARED BY TIGHE & BOND