


# MURRAY COURT - #15

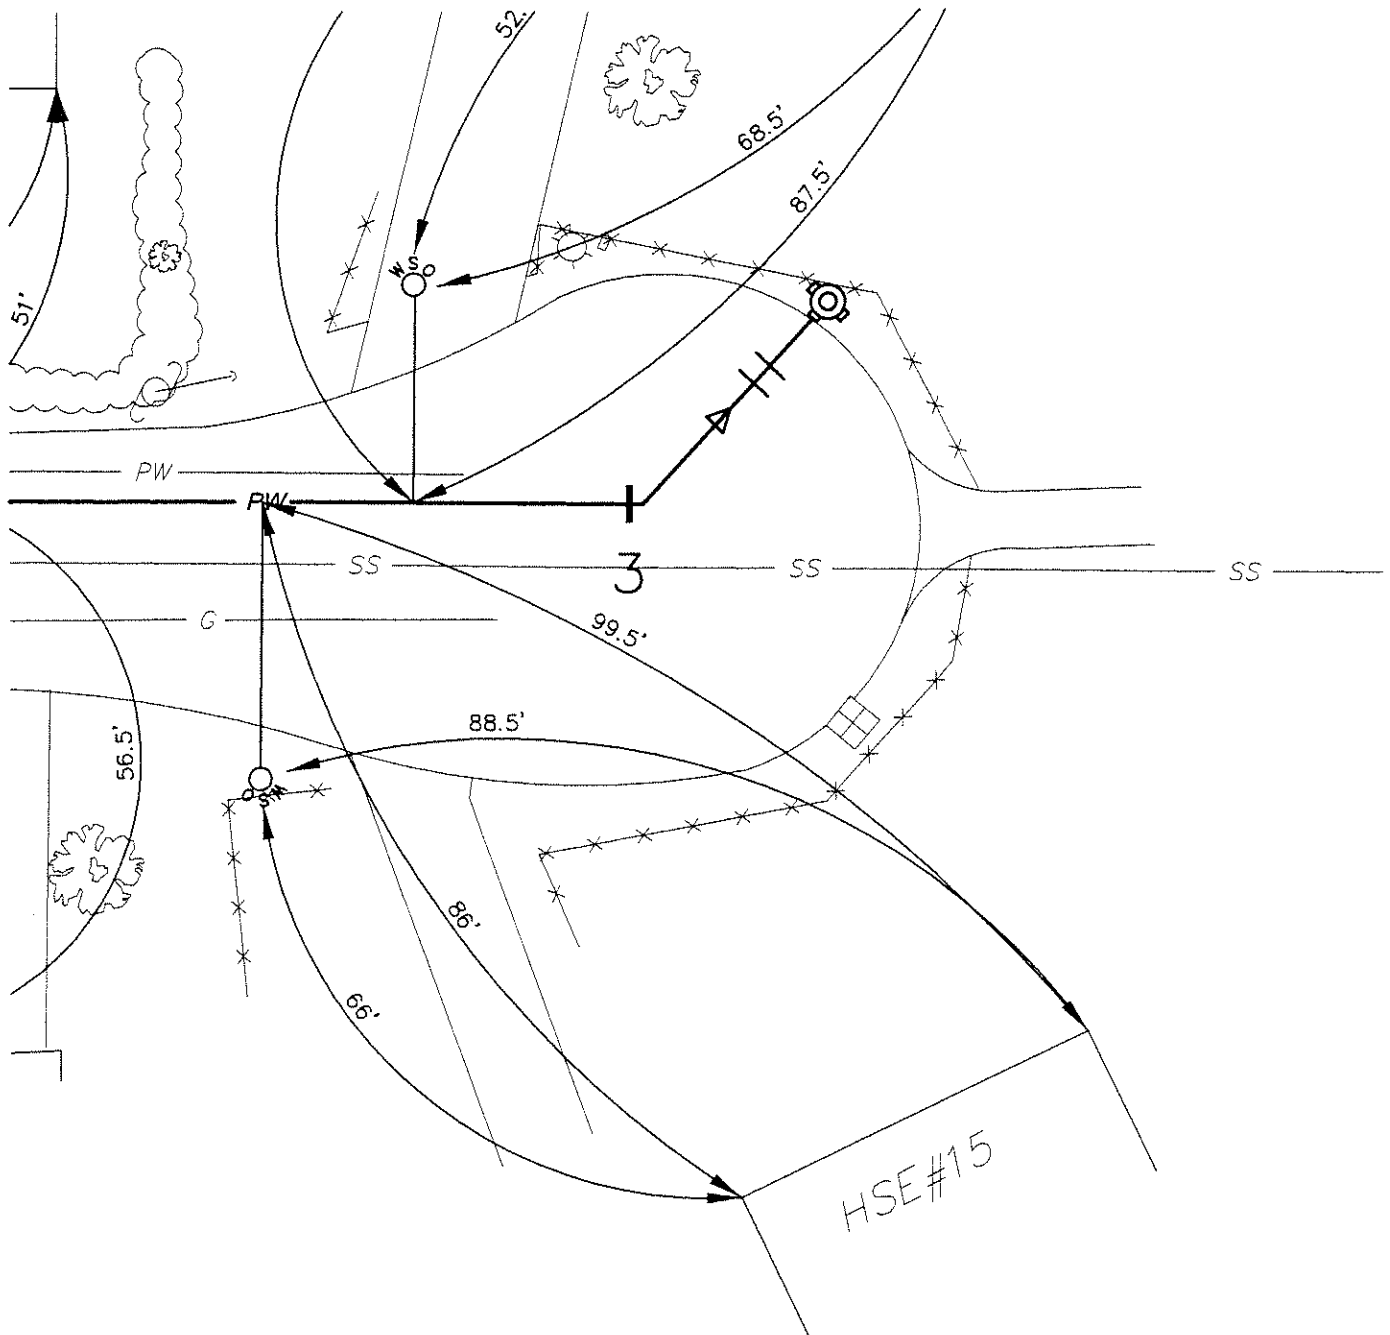

## HOUSE SERVICE INFORMATION:

DEPTH AT MAIN: 5'  
 DEPTH AT PROPERTY LINE: 5'  
 DATE INSTALLED: 10/05/04

PREPARED BY TIGHE & BOND