


NEWBURY AVENUE - #61

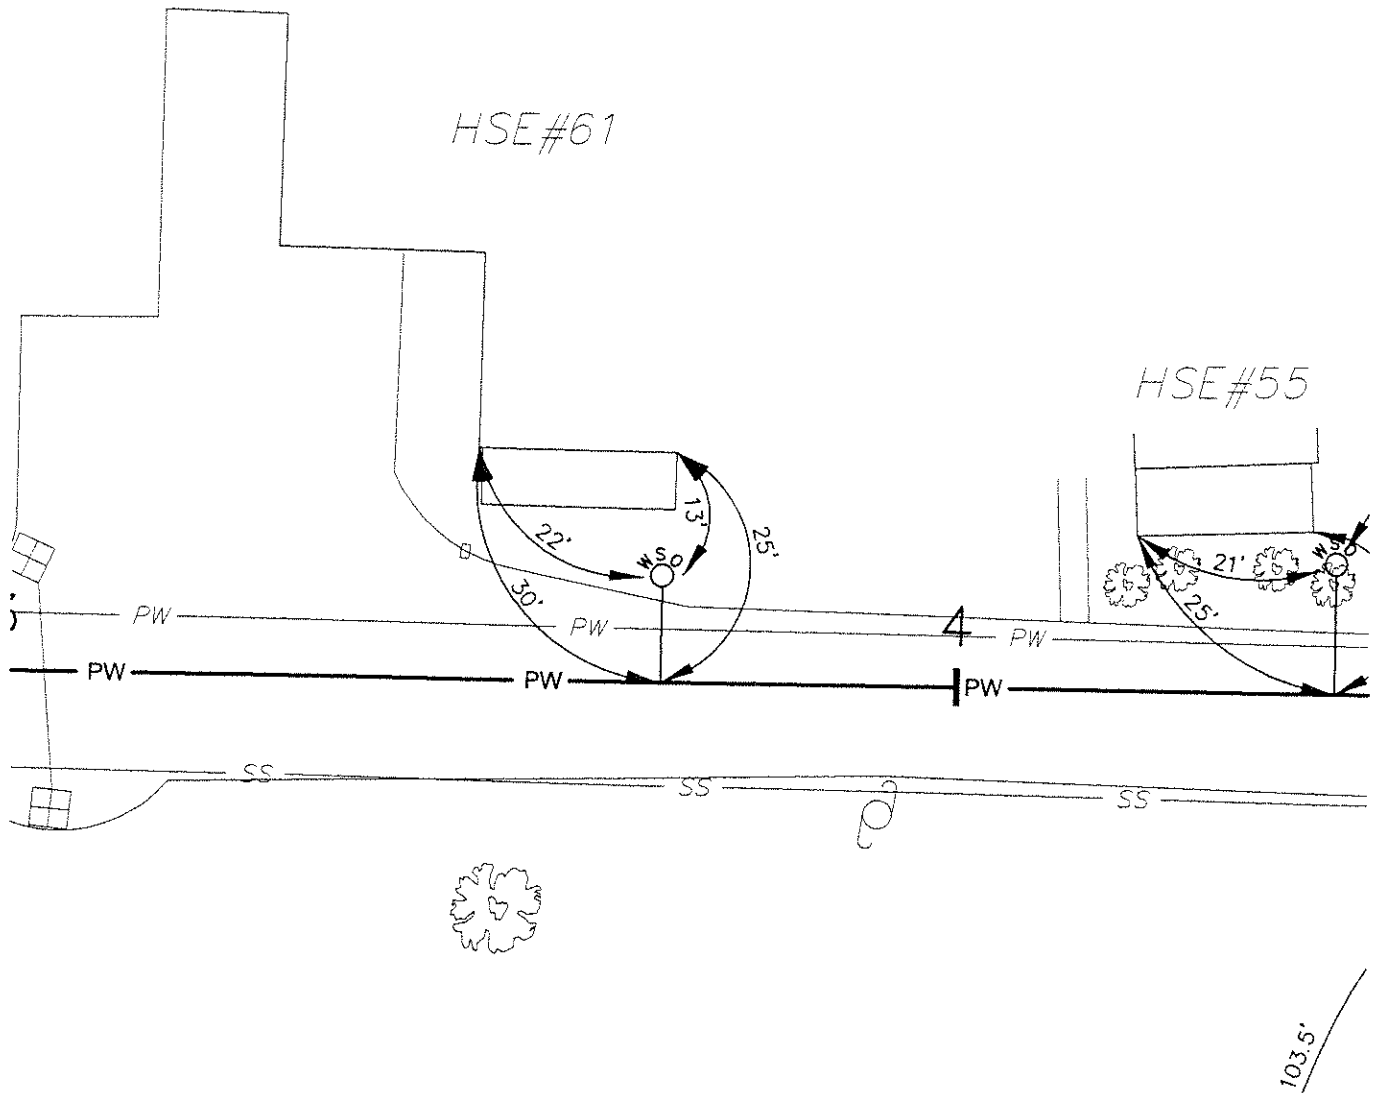

HOUSE SERVICE INFORMATION:

DEPTH AT MAIN: 5.5'
DEPTH AT PROPERTY LINE: 5'
DATE INSTALLED: 10/14/04

PREPARED BY TIGHE & BOND