


62 NORTH CIRCLE DRIVE

12-15-2021

#62

1" CTS
M-C
27'

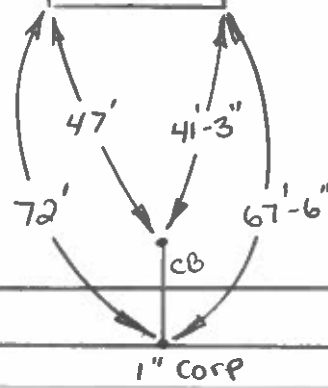

8" DI