

NO. STREET


DATE INST.

MAKE:

SIZE

601 N. MAIN ST.

2-7-07

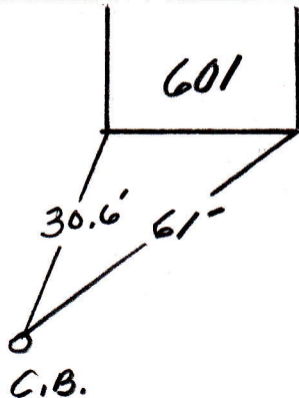

1" COPPER