


137

By Pass -

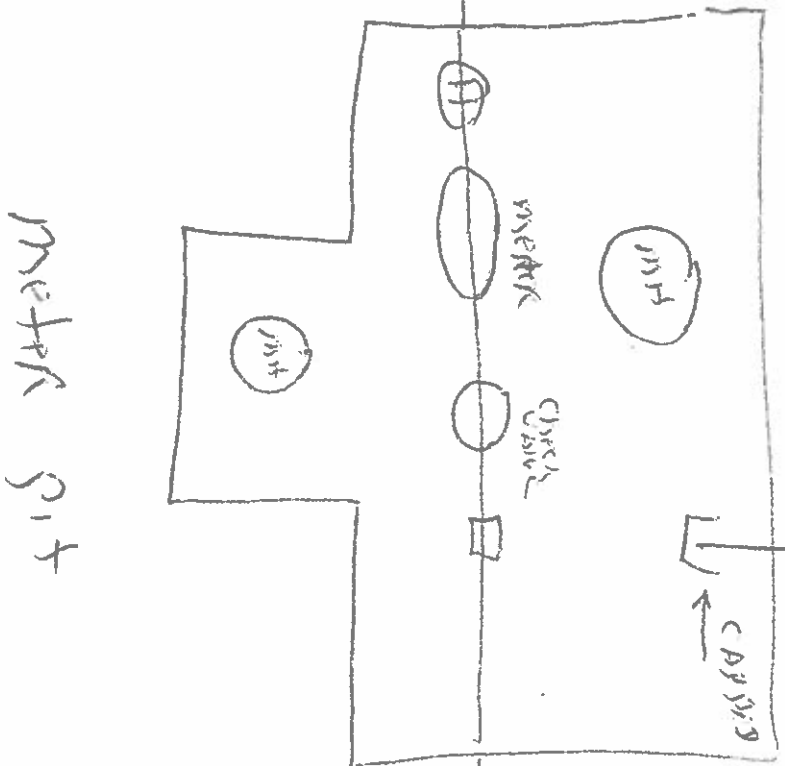

meter sit

city line

Nett MALL

5-7

3ADJ
5VAVC

S.C.T.

72. AC