




EAST LONGMEADOW DEPARTMENT OF PUBLIC WORKS

Job: 30 Old Pasture Drive (water)

Sheet No: _____ of _____

Calculated By: Pope Date 10-28-2022

Scale: _____

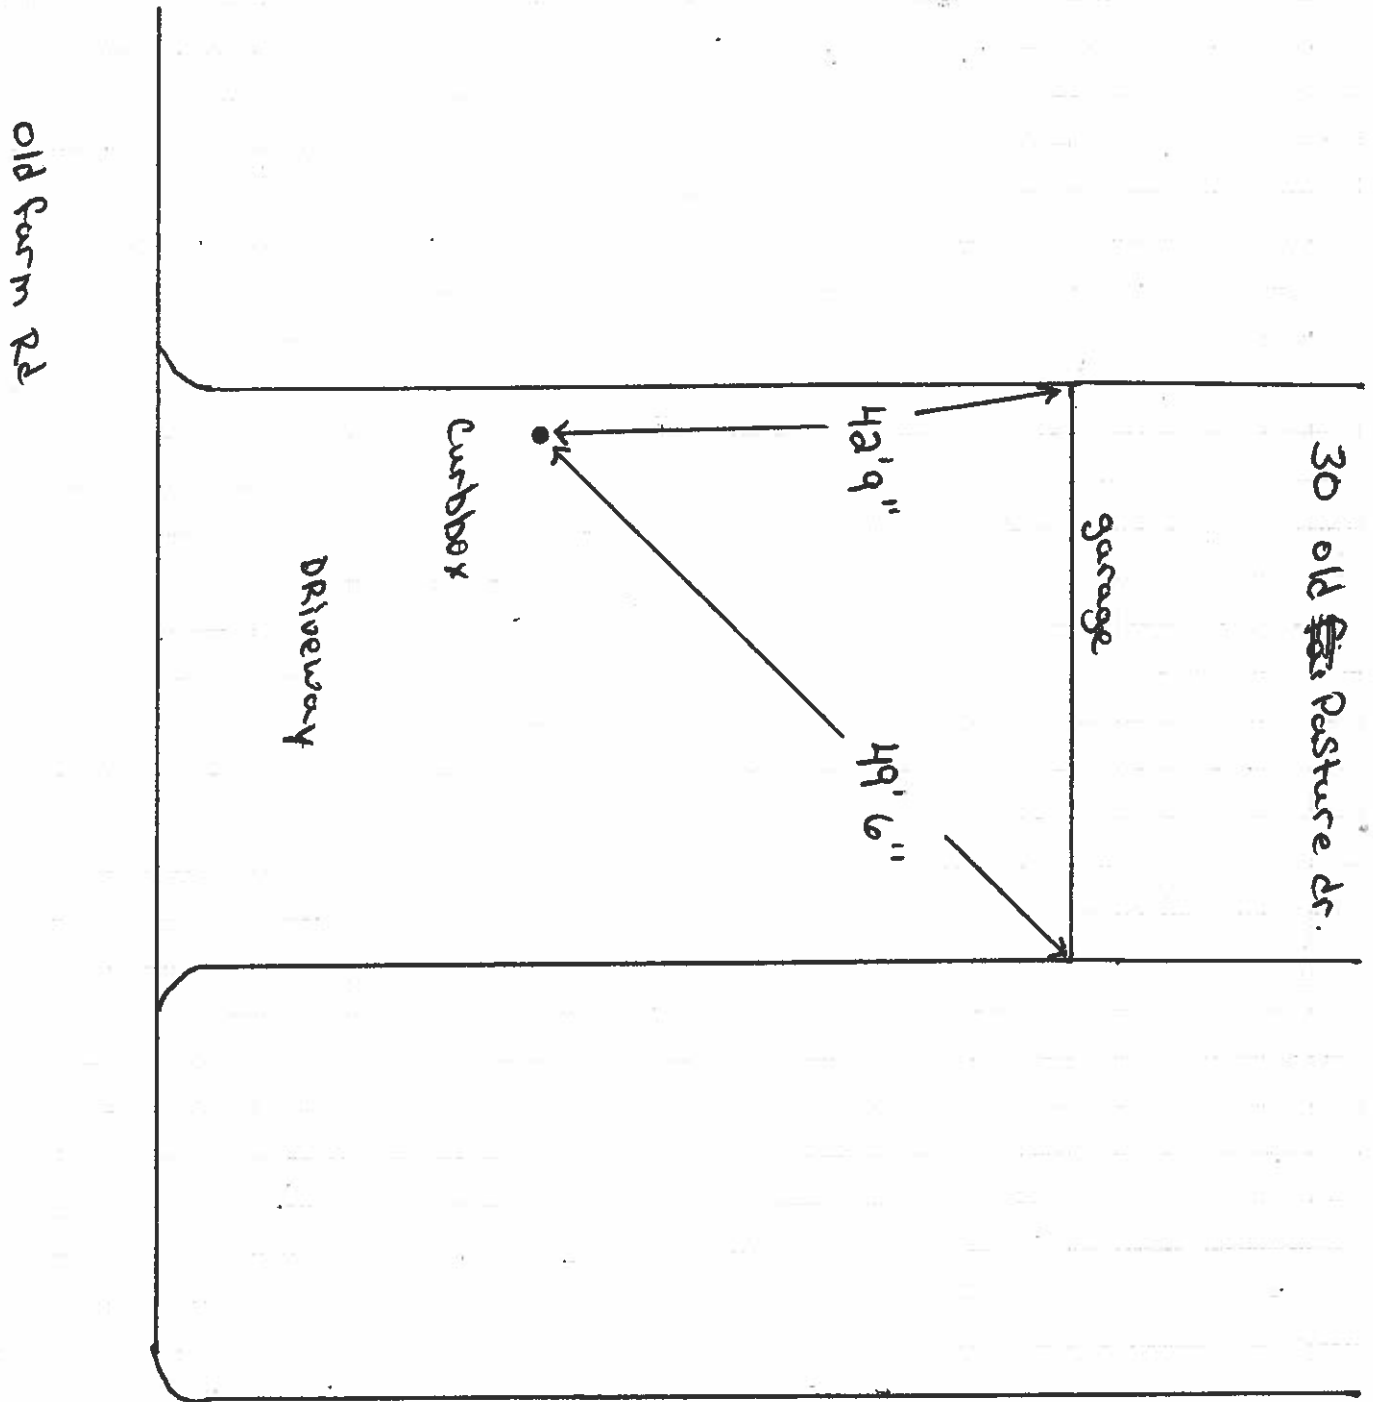

Old Pasture Dr.