


NO. STREET

DATE INST.

MAKE:

SIZE

3 Orange Street 11/1/04 Badger 1"

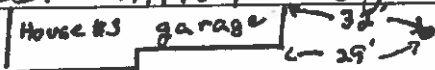

Orange St.

Kensington