

NO. STREET


DATE INST.

MAKE:

SIZE

80 ORCHARD RD (LOT 41) 7/23/02 BADGER 1"

ORCHARD RD.

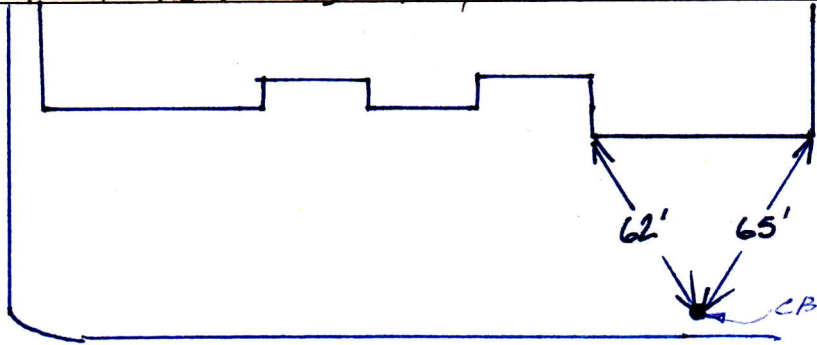

PINE GROVE CIRCLE