

NO. STREET

154

DATE INST.

MAKE:


SIZE

ORCHARD ROAD

2/16/06

BADGER

1"

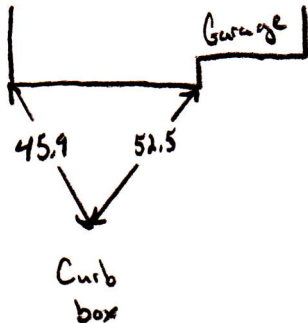

Lot 21