

NO. STREET: Lot 4


DATE INST:

MAKE:

SIZE

123 Pease Road

12/27/85 Out Badger

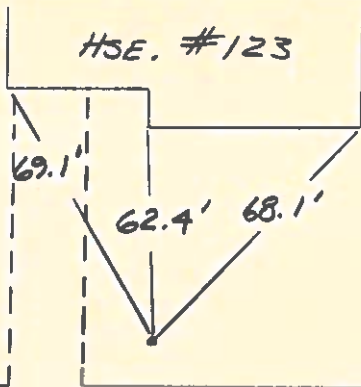

PEASE

ROAD