

NO. STREET

(Bldg. 38)

DATE INST.

MAKE:


SIZE

323 Pinchurst Drive

4/5/02

Badger

1"

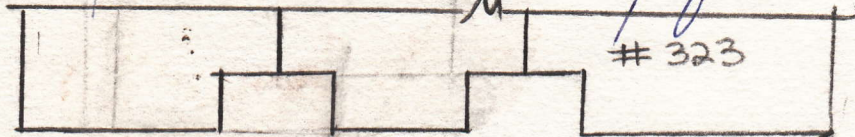

C.B.

46'

57'

CATCH
C.B. BASIN