




# EAST LONGMEADOW DEPARTMENT OF PUBLIC WORKS

Job: 29 Pleasant St (water)

Sheet No: \_\_\_\_\_ of \_\_\_\_\_

Calculated By: Pope Date 10-25-19

Scale: \_\_\_\_\_

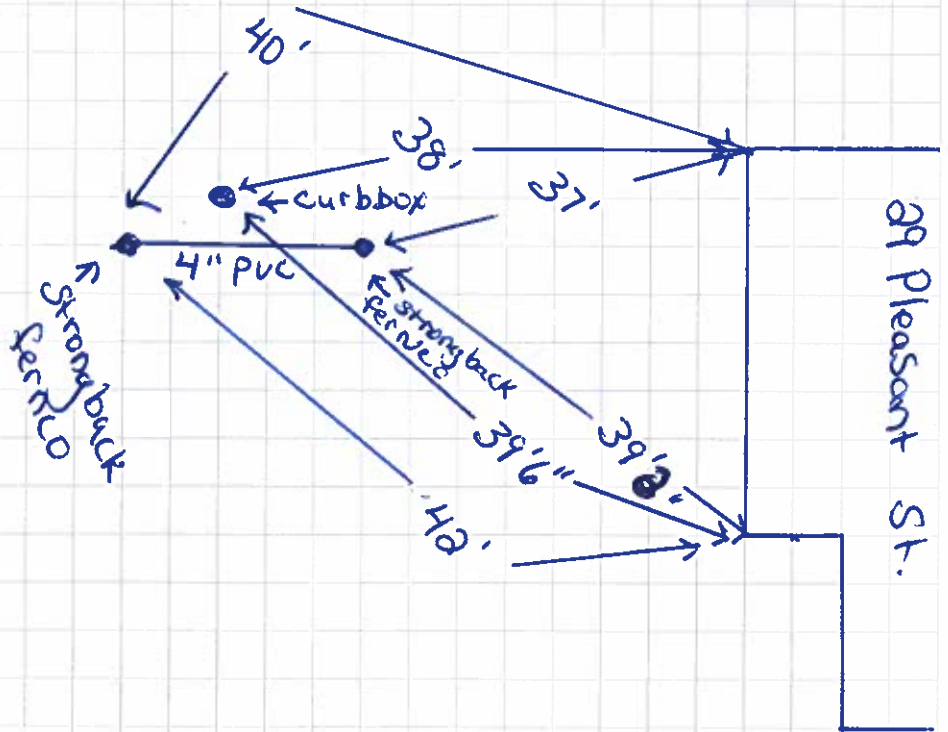

Curbbox is 6' deep, Sewer Service is 1" Away from Curbbox  
3" below Sewer Service is a 6" pipe orangeburg  
we believe this pipe is footing drain pipe