

NO. STREET:

DATE INST:

MAKE:


SIZE

34 Pleasant St.

1/1/47

~~H~~ersey

5/8"

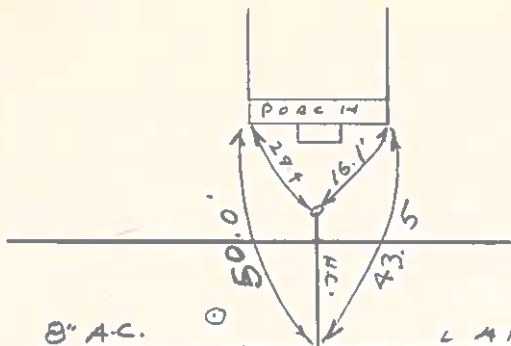

L 410 IN 1951