


NO. STREET

DATE INST.

MAKE:

SIZE

163 PLEASANT ST.

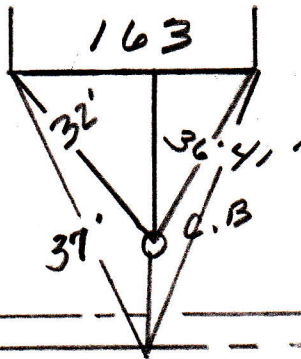

$\frac{3}{4}$ " COPPER

3" DEEP

FIBER

6" C.I.

FIBER