

NO. STREET:


DATE INST:

MAKE:

SIZE

BROWNSTONE GARDENS

BLDG "G"

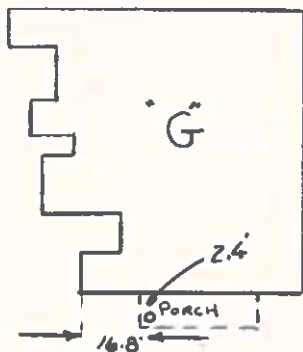

W.D.