

EAST LONGMEADOW DEPARTMENT OF PUBLIC WORKS


Job: 24 Pondview (water)

Sheet No: _____ of _____

Calculated By: Ruel Date 1-9-18

Scale: _____

pondview

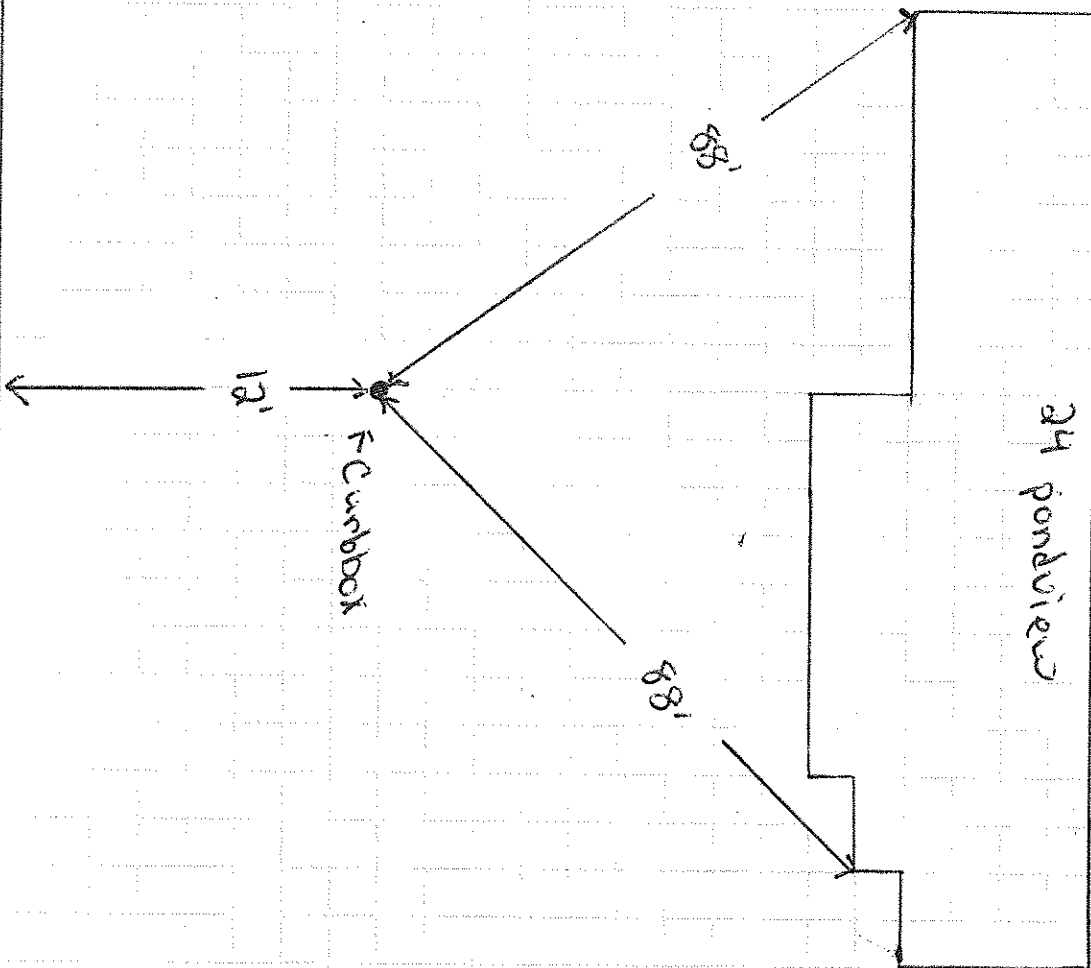

curbline