




EAST LONGMEADOW DEPARTMENT OF PUBLIC WORKS

Job: Water Service

Sheet No: _____ of _____

Calculated By: Jash Date 6-16-16

Scale: CurB Box

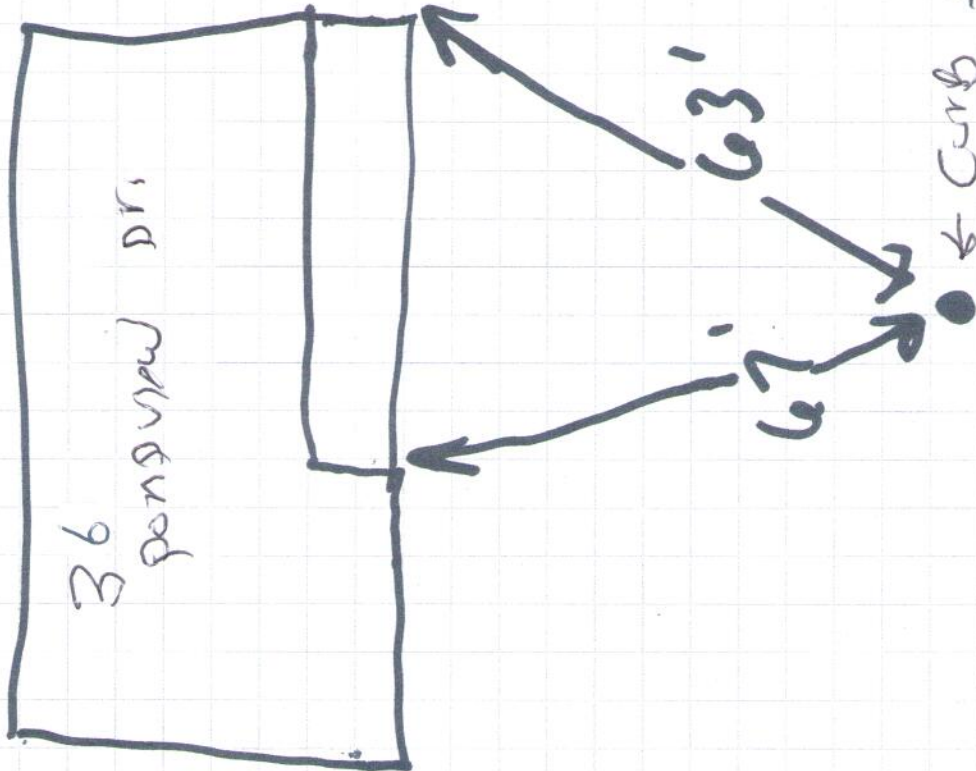

36 Pondview Dr