

NO. STREET

DATE INST.

MAKE:


SIZE

1 PORTER ROAD

8/28/02

BADGER

2"

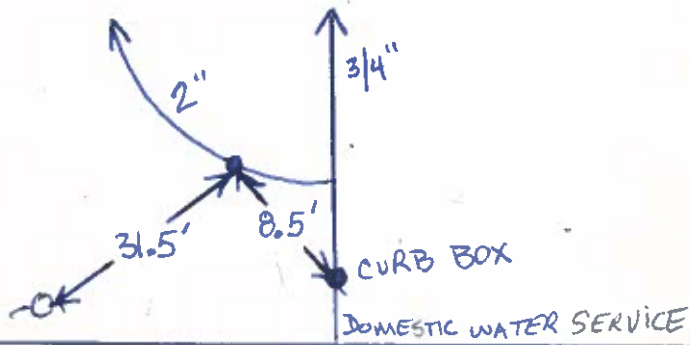

PORTER ROAD