




EAST LONGMEADOW DEPARTMENT OF PUBLIC WORKS

Job: 141 Porter Rd. (water)

Sheet No: _____ of _____

Calculated By: Pope Date 11-26-19

Scale: _____

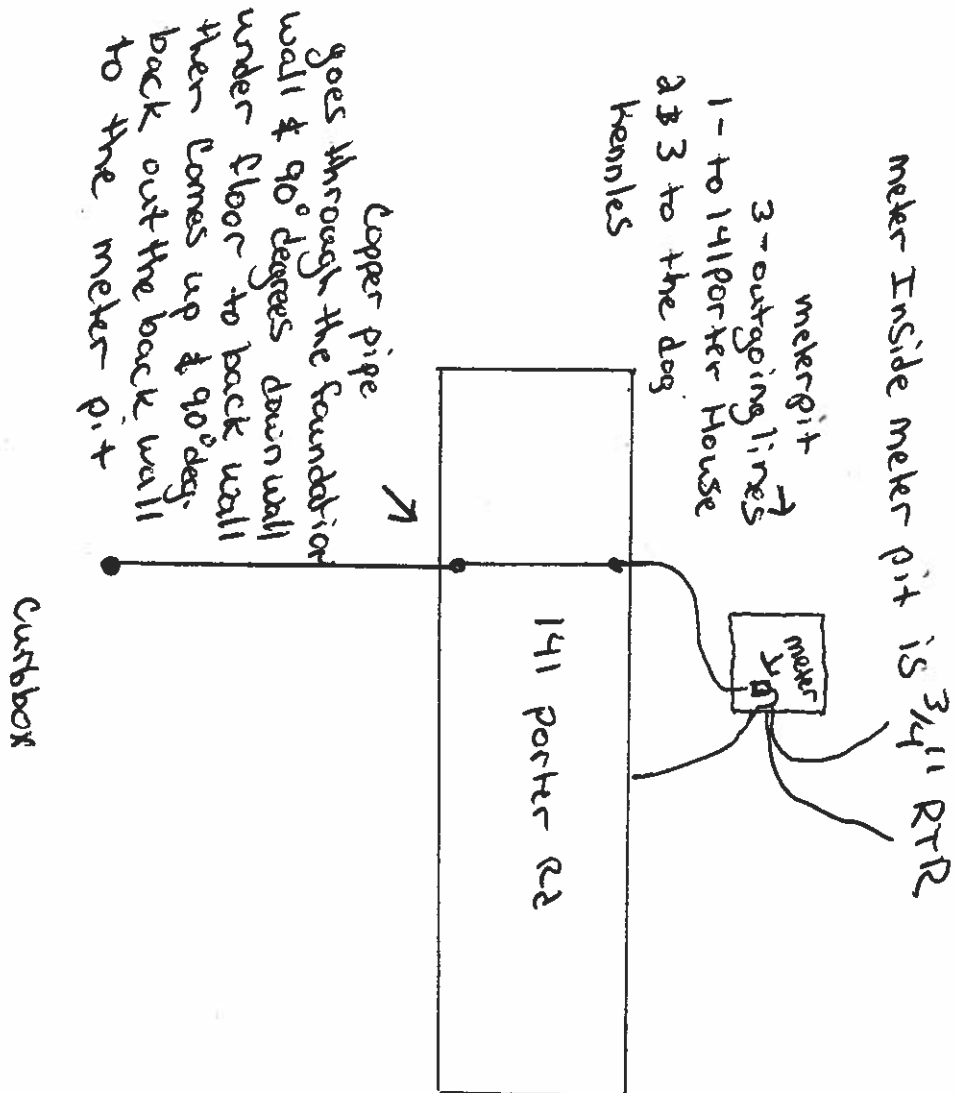

Porter Rd.