

NO. STREET


DATE INST.

MAKE:

SIZE

437 PORTER ROAD

5-23-13

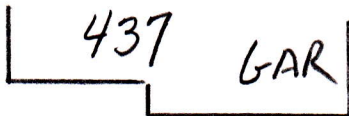

1" COPPER

