

NO. STREET


DATE INST.

MAKE:

SIZE

10 RAMONA'S WAY

7-21-11

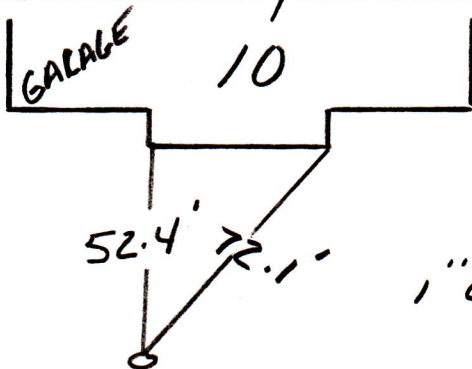

1" COPPER