


STREET ADDRESS: HSE#16 RANKIN AVENUE

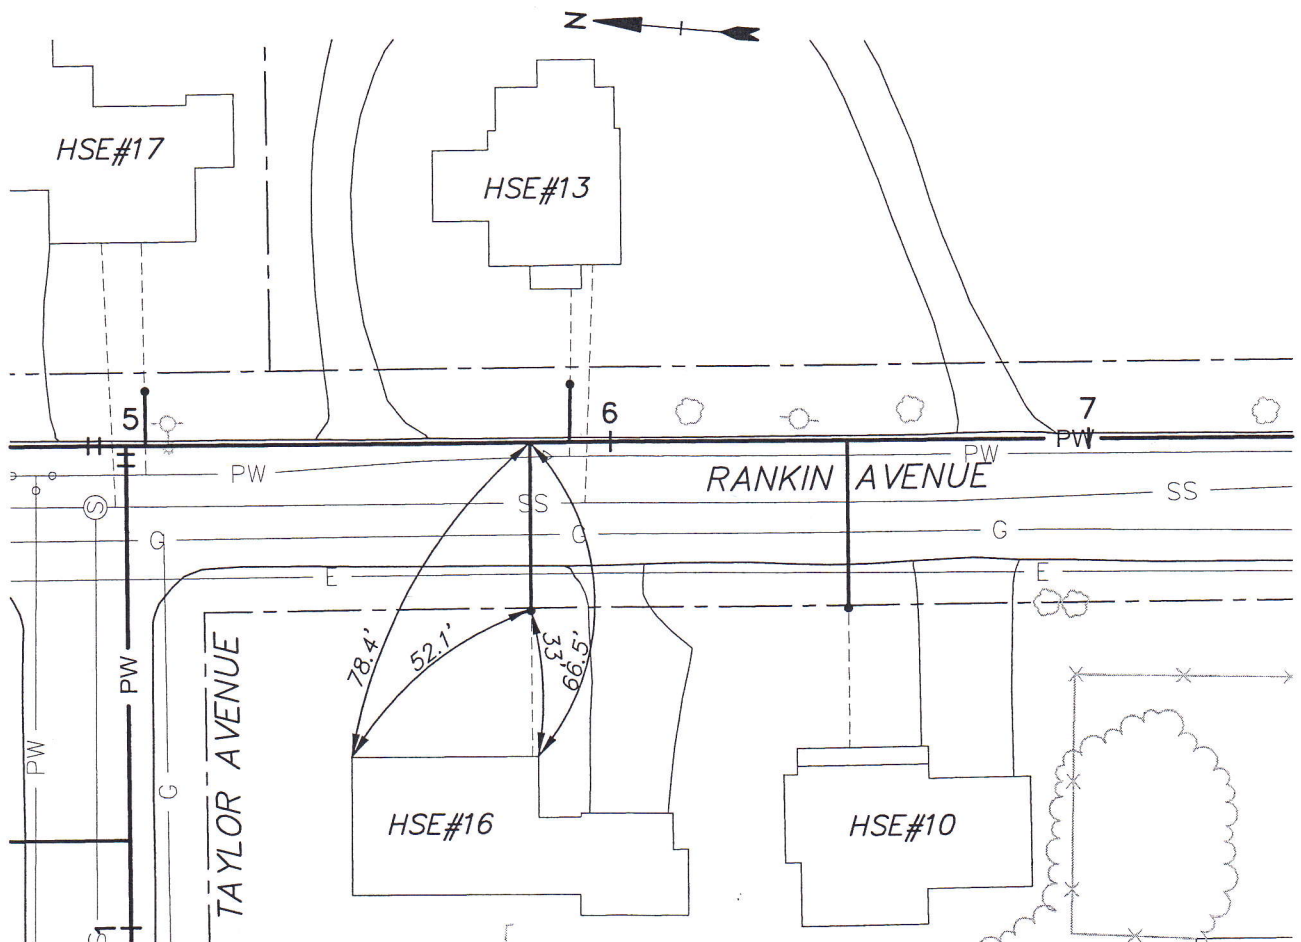

LOAM & SEED _____
 BIT. DRIVEWAY _____
 BIT. CURBS _____
 BIT. SIDEWALK _____
 CONC. CURB _____
 CONC. SIDEWALK _____

SERVICE INSTALLED: 9-18-07
 SIZE: 1"
 MATERIAL: 1-CORP., 1-C. STOP WITH BOX
 DEPTH AT MAIN: 5.0'
 DEPTH AT CURB STOP: 5.0'
 LENGTH OF Cu PIPE: 35.0'+1.0' = 36.0'