


STREET ADDRESS: HSE#34 RANKIN AVENUE

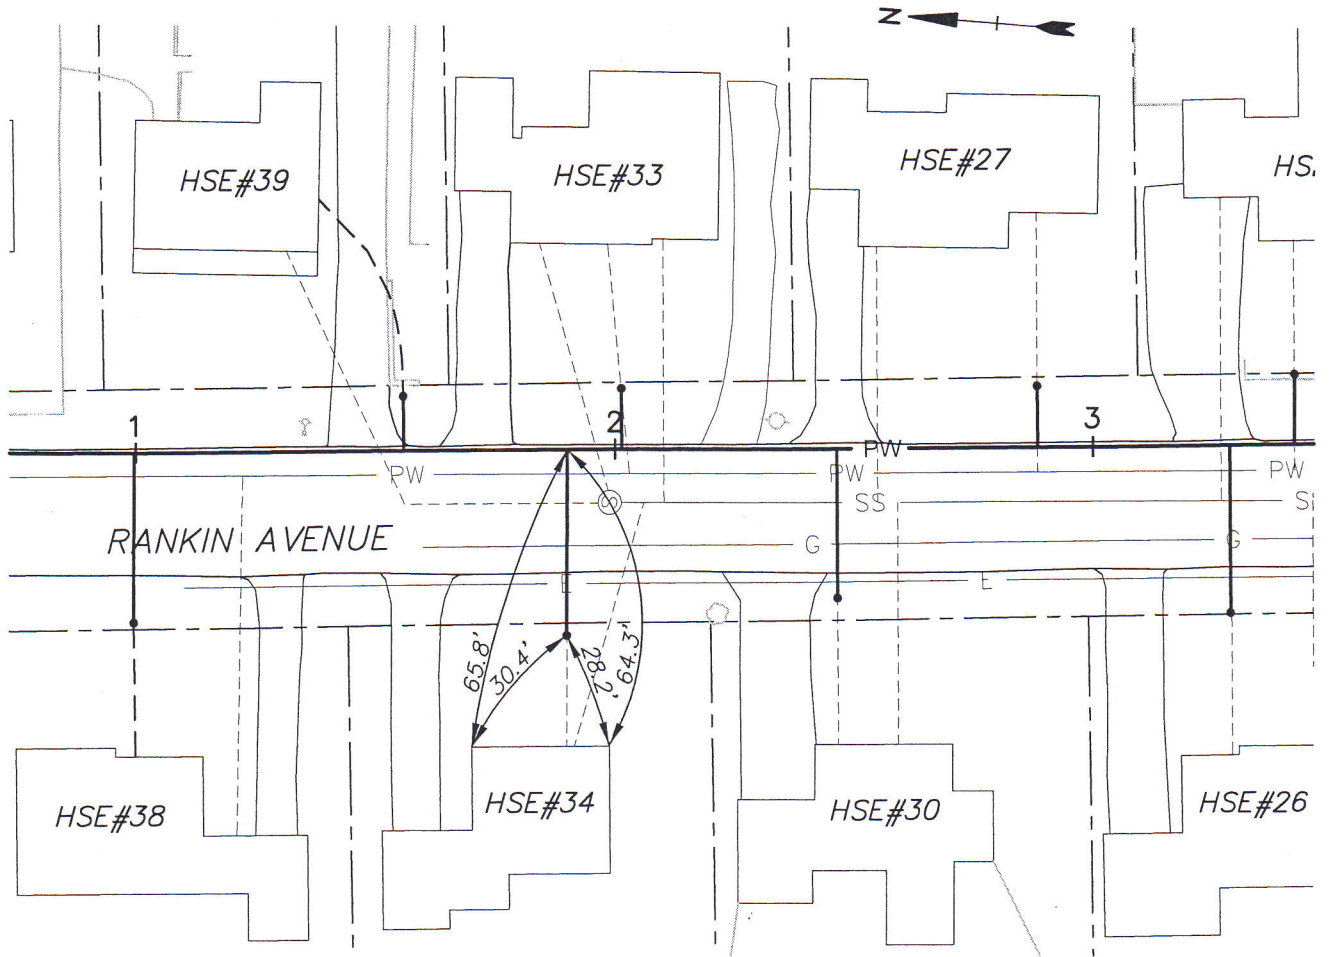

LOAM & SEED	_____
BIT. DRIVEWAY	_____
BIT. CURBS	_____
BIT. SIDEWALK	_____
CONC. CURB	_____
CONC. SIDEWALK	_____

SERVICE INSTALLED: 9-18-07

SIZE: 1"

MATERIAL: 1-CORP., 1-C. STOP WITH BOX

DEPTH AT MAIN: 5.5'

DEPTH AT CURB STOP: 4.8'

LENGTH OF Cu PIPE: $39.5+1.5' = 41.0'$