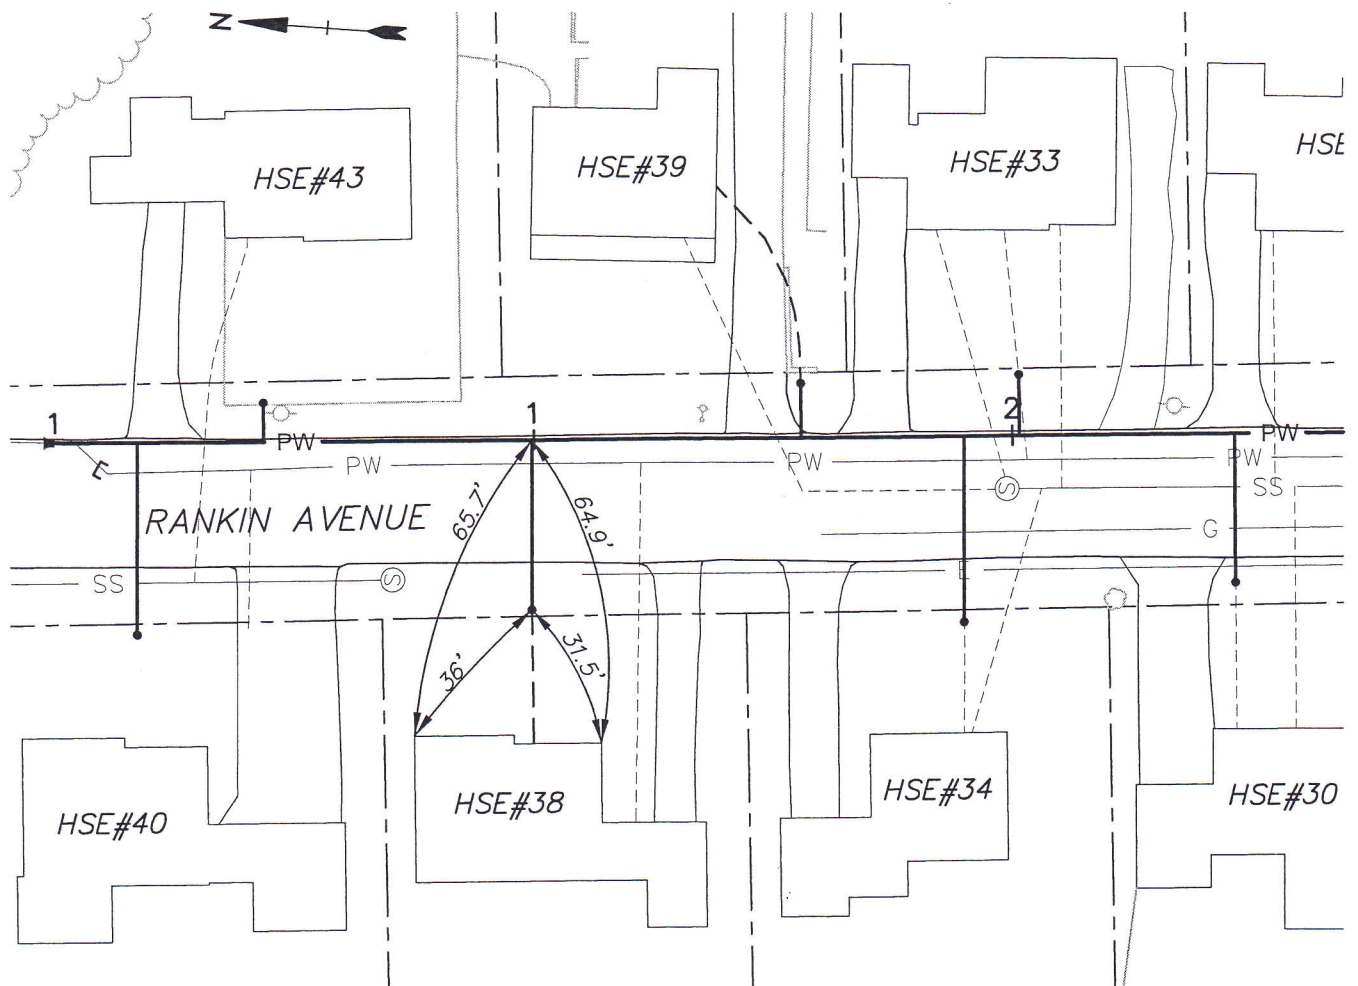


STREET ADDRESS: HSE#38 RANKIN AVENUE

LOAM & SEED _____

BIT. DRIVEWAY _____

BIT. CURBS _____

BIT. SIDEWALK _____

CONC. CURB _____

CONC. SIDEWALK _____

SERVICE INSTALLED: 9-17-07

SIZE: 1"

MATERIAL: 1-CORP., 1-C. STOP WITH BOX

DEPTH AT MAIN: 5.2'

DEPTH AT CURB STOP: 4.8'

LENGTH OF Cu PIPE: 36.0+2.0' = 38.0'