


EAST LONGMEADOW DEPARTMENT OF PUBLIC WORKS

Job: 44 - 48 Rankin Ave (Sewer)

Sheet No: _____ of _____

Calculated By: Pope Date 5-31-17

Scale: Repair on sewer main (pipe through main)

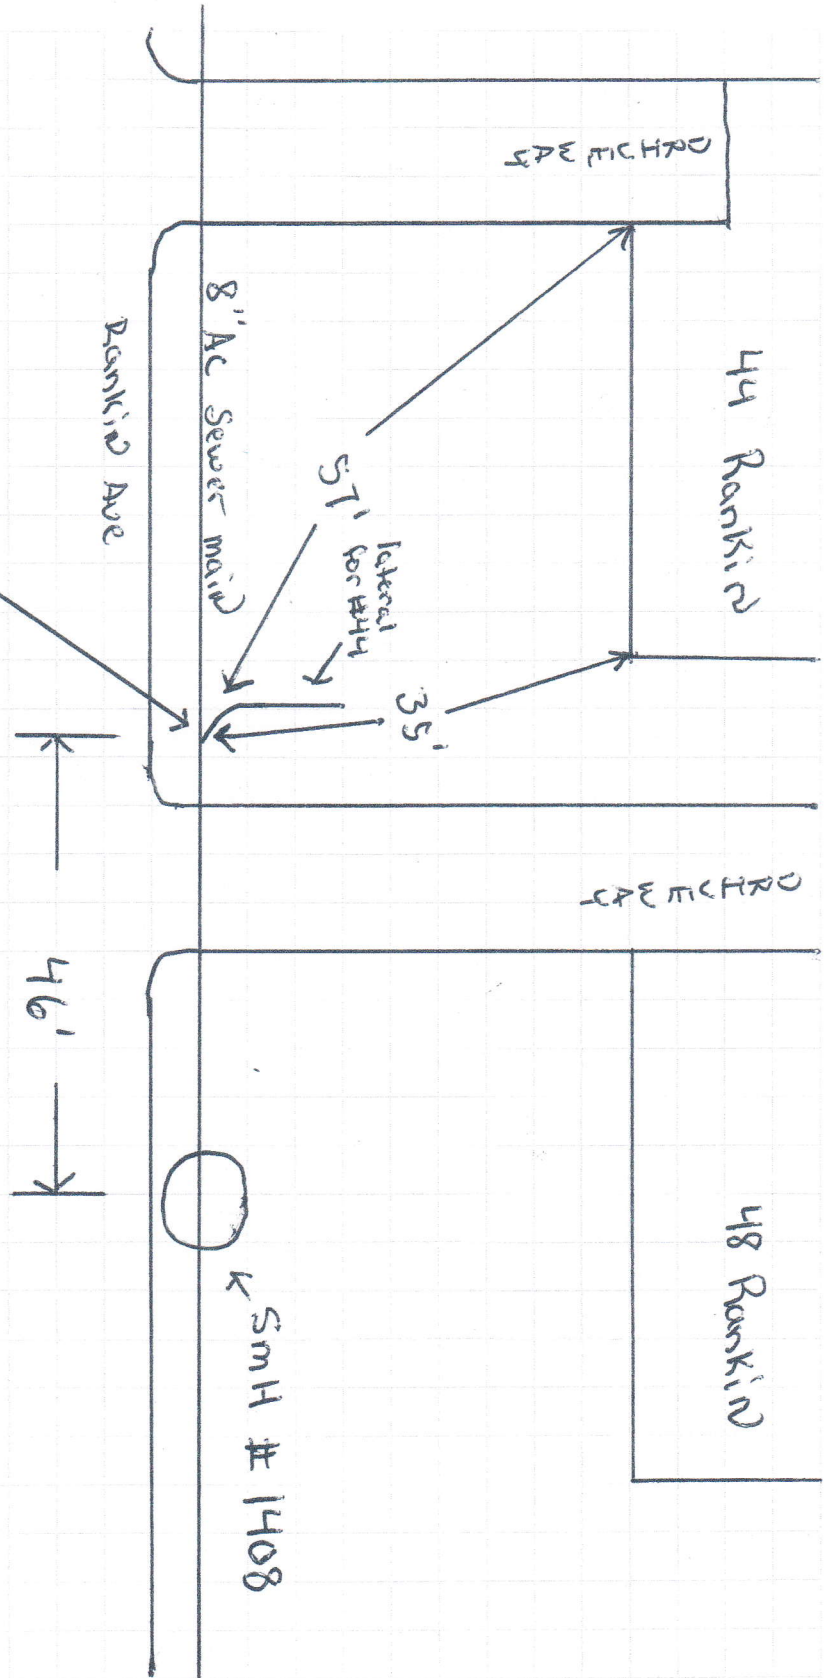

Repair made to 8" Ac Sewer main
parts used:

8" Ac Sewer main 4' 6" deep
Fiber optic 2' away from Sewer main
Fiber optic depth 36"

8" PVC pipe
8" Tee Y for lateral
8" x 6" Reducer for lateral
6" x 4" Reducer for lateral