


16 RIDGE ROAD

11-22-2021

#16

Garage

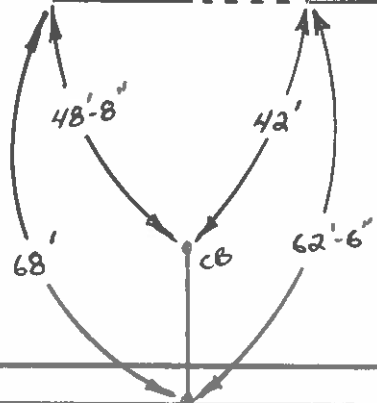

1" c+sp
m-c
24'

1" corP

8" DI