

33 RIDGE ROAD


11-23-2021

1"ctsp  
M-C  
31'

#33

side of  
House

EXIST  
CIRCLE

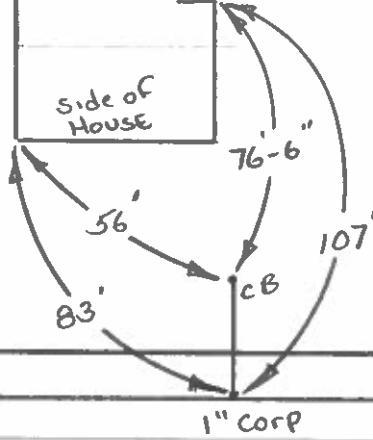

8" DI