


42 RIDGE ROAD

11-23-2021

1"ctsp
m-c
24'

#42

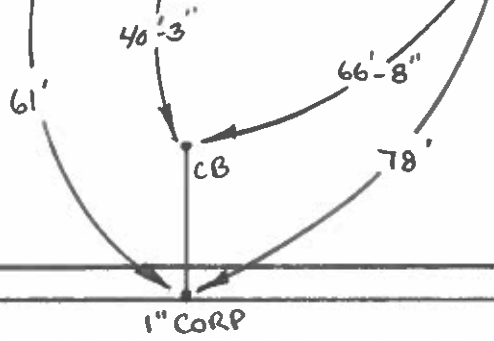

8" DI

1" CORP