


47 RIDGE ROAD

11-30-2021

Garage

#47

1' etsp
m-c
33'-1"

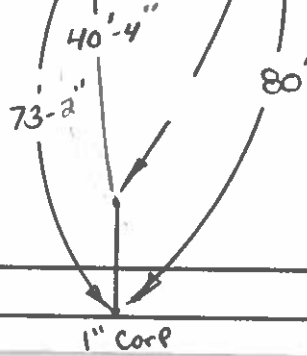

8' DI