


53 RIDGE ROAD

11-30-2021

Garage

#53

1" ctsP
m-c
36'

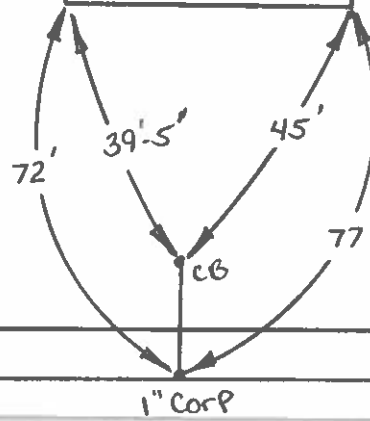

8" DI

1" Corp