


65 RIDGE ROAD

11-30-2021

#65

Garage

1" ctsp  
m-c  
31'

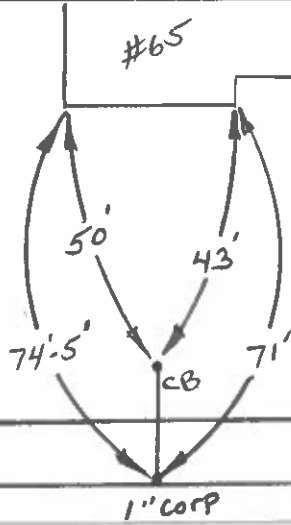

8" DI